


USE TYPEWRITER OR BALL POINT PEN—PRESS FIRMLY, PRINT CLEARLY.

WATER WELL RECORD
KSA 82a-1201-1215

Kansas Department of Health and Environment—Division of Environment
(Water well Contractors)
Topeka, Kansas 66620

1. Location of well:	County Wyandotte	Fraction SE 1/4 NE 1/4 NE 1/4	Section number 13	Township number T 10-S S	Range number R 24
2. Distance and direction from nearest town or city: Street address of well location if in city:	5 mi +		3. Owner of well: Shawnee Const. Co. R.R. or street: 6319 Kansas Avenue City, state, zip code: Kansas City, KS 66111		

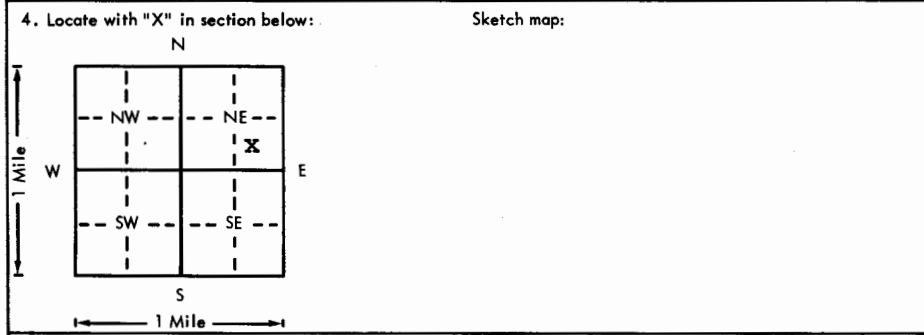

6. Bore hole dia. **30** in. Completion date **5-10-77**
Well depth **100** ft.

7. Cable tool Rotary Driven Dug
 Hollow rod Jetted Bored Reverse rotary

8. Use: Domestic Public supply Industry
 Irrigation Air conditioning Stock
 Lawn Oil field water Other

9. Casing: Material **steel** Height: Above or below
Threaded Welded Surface **2' above** n.
RMP PVC Weight **33** lbs./ft.
Dia. **16** in. to **70** ft. depth Wall Thickness: inches or
Dia. in. to ft. depth gage No. **1 1/2"**

5. Type and color of material	From	To
Topsoil	0	2
Brown Silty clay - moist - stratified	2	10
Silt - fine silty sand - wet	10	30
Brown gray medium sand - wet	30	50
Gray medium coarse sand - wet	50	80
Gray medium coarse sand - trace of gravel	70	80
Medium sand-lignite - trace of gravel	80	100
Cobbles @ 95		
(Use a second sheet if needed)		

10. Screen: Manufacturer's name **Doerr**
Type **punched** Dia. **16"**
Slot/gauze **1/16"** Length **30**
Set between **70** ft. and **100** ft.
Gravel pack? Size range of material **1/2"**

11. Static water level: **16** ft. below land surface Date **5-10-77** mo./day/yr.

12. Pumping level below land surfaces:
50 ft. after **10** hrs. pumping **1500** g.p.m.
ft. after _____ hrs. pumping _____ g.p.m.
Estimated maximum yield **1500** g.p.m.

13. Water sample submitted: _____ mo./day/yr.
Yes No Date _____

14. Well head completion: **Temp. Dis. head**
Pitless adapter _____ Inches above grade

15. Well grouted? **no**
With: Neat cement Bentonite Concrete
Depth: From _____ ft. to _____ ft.

16. Nearest source of possible contamination:
ft. _____ Direction _____ Type _____
Well disinfected upon completion? _____ Yes No

17. Pump: Not installed
Manufacturer's name **Aurora**
Model number _____ HP **60** Volts _____
Length of drop pipe **60** ft. capacity **7000** g.p.m.
Type:
 Submersible Turbine
 Jet Reciprocating
 Centrifugal Other

18. Elevation:

19. Remarks:
This is a temporary well for dewatering purpose only. Upon completion of dewatering, casing and screen will be removed and remaining hole filled.
Our contract with Shawnee states "All holes shall be filled to the satisfaction of the owner and/or engineers at no cost to our firm."

Topography:
 Hill
 Slope
 Upland
 Valley

20. Water well contractor's certification:
This well was drilled under my jurisdiction and this report is true to the best of my knowledge and belief.
Southern Wellpoint Co., Inc. #285
Business name License No. _____
Address **2935 North Toledo, Tulsa, OK**
Signed **A.W. Macomber** Date **7-1-77**
Authorized representative

A.W. Macomber, President
Form WWC-5

Forward the white, blue and pink copies to the Department of Health and Environment