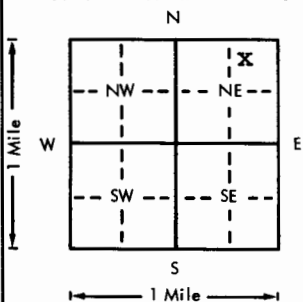


USE TYPEWRITER OR BALL POINT PEN-PRESS FIRMLY, PRINT CLEARLY.

WATER WELL RECORD
KSA 82a-1201-1215

Kansas Department of Health and Environment-Division of Environment
(Water well Contractors)
Topeka, Kansas 66620

1. Location of well:	County WYANDOTTE	Fraction NW_{1/4} NE_{1/4} NE_{1/4}	Section number 13	Township number T 10 S	Range number S R 24
2. Distance and direction from nearest town or city: Street address of well location if in city: West 5 mi ±			3. Owner of well: Shawnee Const. Co. R.R. or street: 6319 Kansas Avenue City, state, zip code: Kansas City, KS 66111		
4. Locate with "X" in section below: Sketch map: 			6. Bore hole dia. 30 in. Completion date 9-12-77 Well depth 100 ft.		
5. Type and color of material			7. <input type="checkbox"/> Cable tool <input type="checkbox"/> Rotary <input type="checkbox"/> Driven <input type="checkbox"/> Dug <input type="checkbox"/> Hollow rod <input type="checkbox"/> Jetted <input type="checkbox"/> Bored <input checked="" type="checkbox"/> Reverse rotary		
8. Use: <input type="checkbox"/> Domestic <input type="checkbox"/> Public supply <input type="checkbox"/> Industry <input type="checkbox"/> Irrigation <input type="checkbox"/> Air conditioning <input type="checkbox"/> Stock <input type="checkbox"/> Lawn <input type="checkbox"/> Oil field water <input checked="" type="checkbox"/> Other			9. Casing: Material steel Height: Above or below Threaded <input type="checkbox"/> Welded <input checked="" type="checkbox"/> Surface 2 in. RMP <input type="checkbox"/> PVC <input type="checkbox"/> Weight 42 lbs./ft. Dia. 16" to 60" depth Wall Thickness: inches or Dia. <input type="checkbox"/> in. to <input type="checkbox"/> ft. depth gage No. 1/4"		
10. Screen: Manufacturer's name Johnson			11. Static water level: _____ mo./day/yr. _____ ft. below land surface Date _____		
11. Type and color of material			12. Pumping level below land surfaces: 50 ft. after 10 hrs. pumping 1500 g.p.m. _____ ft. after _____ hrs. pumping _____ g.p.m. Estimated maximum yield 1500 g.p.m.		
12. Type and color of material			13. Water sample submitted: _____ mo./day/yr. <input type="checkbox"/> Yes <input checked="" type="checkbox"/> No Date _____		
13. Type and color of material			14. Well head completion: Temp. Dis. head <input type="checkbox"/> Pitless adapter _____ Inches above grade		
14. Type and color of material			15. Well grouted? no With: <input type="checkbox"/> Neat cement <input type="checkbox"/> Bentonite <input type="checkbox"/> Concrete Depth: From _____ ft. to _____ ft.		
15. Type and color of material			16. Nearest source of possible contamination: ft. _____ Direction _____ Type _____ Well disinfected upon completion? <input type="checkbox"/> Yes <input checked="" type="checkbox"/> No		
16. Type and color of material			17. Pump: Not installed Manufacturer's name F. Morse Model number MC-14 HP 75 Volts _____ Length of drop pipe 60 ft. capacity 2500 g.p.m. Type: <input type="checkbox"/> Submersible <input checked="" type="checkbox"/> Turbine <input type="checkbox"/> Jet <input type="checkbox"/> Reciprocating <input type="checkbox"/> Centrifugal <input type="checkbox"/> Other		
17. Type and color of material			20. Water well contractor's certification: This well was drilled under my jurisdiction and this report is true to the best of my knowledge and belief. #235 Southern Wellpoint Co., inc. Business name _____ License No. _____ Address 2935 N. Toledo, Tulsa, OK Signed <i>AW Macomber</i> Date 5-23-78 Authorized representative		
18. Elevation:			19. Remarks: Our contract with shawnee states "All holes shall be filled to the satisfaction of the owner and/or engineers at no cost to our firm."		
20. Elevation:			21. Remarks:		

Forward the white, blue and pink copies to the Department of Health and Environment

Form WWC-5