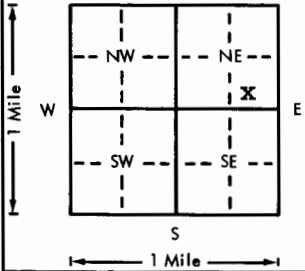


USE TYPEWRITER OR BALL POINT PEN-PRESS FIRMLY, PRINT CLEARLY.

WATER WELL RECORD  
KSA 82a-1201-1215

Kansas Department of Health and Environment-Division of Environment (Water well Contractors) Topeka, Kansas 66620

1. Location of well:	County <b>Wyandotte</b>	Fraction <b>SW 1/4 NE 1/4 NE 1/4</b>	Section number <b>13</b>	Township number <b>T 10-S</b>	Range number <b>S R 24</b>	<b>E</b> <del>SW</del>
2. Distance and direction from nearest town or city: Street address of well location if in city:			3. Owner of well: <b>Shawnee Const. Co.</b> R.R. or street: <b>6319 Kansas Avenue</b> City, state, zip code: <b>Kansas City, KS 66111</b>			
4. Locate with "X" in section below: N W E S 1 Mile 1 Mile			Sketch map: 			
5. Type and color of material			From	To	6. Bore hole dia. <b>30</b> in. Completion date <b>5-18-77</b> Well depth <b>100</b> ft.	
<b>Brown Clay - Silty</b>			<b>0</b>	<b>15</b>	7. <input type="checkbox"/> Cable tool <input type="checkbox"/> Rotary <input type="checkbox"/> Driven <input type="checkbox"/> Dug <input type="checkbox"/> Hollow rod <input type="checkbox"/> Jetted <input type="checkbox"/> Bored <input checked="" type="checkbox"/> Reverse rotary	
<b>Silt - fine sand</b>			<b>15</b>	<b>30</b>	8. Use: <input type="checkbox"/> Domestic <input type="checkbox"/> Public supply <input type="checkbox"/> Industry <input type="checkbox"/> Irrigation <input type="checkbox"/> Air conditioning <input type="checkbox"/> Stock <input type="checkbox"/> Lawn <input type="checkbox"/> Oil field water <input checked="" type="checkbox"/> Other	
<b>Brown coarse sand with gravel</b>			<b>30</b>	<b>60</b>	9. Casing: Material <b>steel</b> Height: Above or below Threaded <input type="checkbox"/> Welded <input checked="" type="checkbox"/> Surface <b>2' above n.</b> RMP <input type="checkbox"/> PVC <input type="checkbox"/> Weight <b>33</b> lbs./ft. Dia. <b>16</b> in. to <b>70</b> ft. depth Wall Thickness: inches or Dia. <input type="checkbox"/> in. to <input type="checkbox"/> ft. depth gage No. <b>2"</b>	
<b>Fine sand</b>			<b>60</b>	<b>70</b>	10. Screen: Manufacturer's name <b>Doerr</b> Type <b>punched</b> Dia. <b>16"</b> Slot/gauze <b>1/16"</b> Length <b>30</b> Set between <b>70</b> ft. and <b>100</b> ft. <input type="checkbox"/> ft. and <input type="checkbox"/> ft. Gravel pack? <input checked="" type="checkbox"/> Size range of material <b>1/2"</b>	
<b>Brown Coarse and gravel</b>			<b>70</b>	<b>100</b>	11. Static water level: <input type="checkbox"/> mo./day/yr. <b>16</b> ft. below land surface Date <b>5-18-77</b>	
					12. Pumping level below land surfaces: <b>50</b> ft. after <b>10</b> hrs. pumping <b>1500</b> g.p.m. <input type="checkbox"/> ft. after <input type="checkbox"/> hrs. pumping <input type="checkbox"/> g.p.m. Estimated maximum yield <b>1500</b> g.p.m.	
					13. Water sample submitted: <input type="checkbox"/> Yes <input checked="" type="checkbox"/> No Date <input type="checkbox"/>	
					14. Well head completion: <b>Temp. Dis. head</b> <input type="checkbox"/> Pitless adapter <input type="checkbox"/> inches above grade	
					15. Well grouted? <b>no</b> With: <input type="checkbox"/> Neat cement <input type="checkbox"/> Bentonite <input type="checkbox"/> Concrete Depth: From <input type="checkbox"/> ft. to <input type="checkbox"/> ft.	
					16. Nearest source of possible contamination: ft. <input type="checkbox"/> Direction <input type="checkbox"/> Type <input type="checkbox"/> Well disinfected upon completion? <input type="checkbox"/> Yes <input checked="" type="checkbox"/> No	
					17. Pump: <input type="checkbox"/> Not installed Manufacturer's name <b>Aurora</b> Model number <input type="checkbox"/> HP <b>60</b> Volts <input type="checkbox"/> Length of drop pipe <b>60</b> ft. capacity <b>7000</b> g.p.m. Type: <input type="checkbox"/> Submersible <input checked="" type="checkbox"/> Turbine <input type="checkbox"/> Jet <input type="checkbox"/> Reciprocating <input type="checkbox"/> Centrifugal <input type="checkbox"/> Other	
					20. Water well contractor's certification: This well was drilled under my jurisdiction and this report is true to the best of my knowledge and belief. #235 <b>Southern Wellpoint Co., Inc.</b> Business name License No. Address <b>2935 N. Toledo, Tulsa, OK</b> Signed <i>A.W. Macomber</i> Date <b>7-1-77</b> Authorized representative	
18. Elevation:  Topography: <input type="checkbox"/> Hill <input type="checkbox"/> Slope <input type="checkbox"/> Upland <input checked="" type="checkbox"/> Valley	19. Remarks: <b>This is a temporary well for dewatering purpose only. Upon completion of dewatering casing and screen will be removed and remaining hole filled. Our contract with Shawnee states "All holes shall be filled to the satisfaction of the owner and/or engineer at no cost to our firm."</b>					

Forward the white, blue and pink copies to the Department of Health and Environment

**A.W. Macomber, President**