

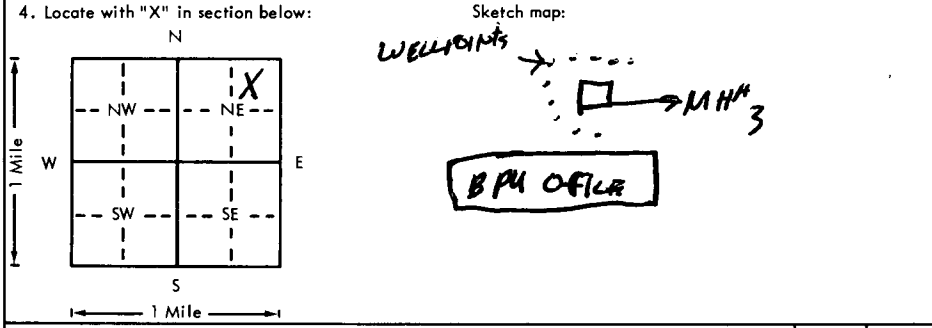
MH #3

not in CF

USE TYPEWRITER OR BALL POINT PEN-PRESS FIRMLY, PRINT CLEARLY.

MH #3 <sup>Install</sup> ~~Remove~~  
WATER WELL RECORD  
KSA 82a-1201-1215

Kansas Department of Health and Environment-Division of Environment  
(Water well Contractors)  
Topeka, Kansas 66620

1. Location of well: County <b>WYANDOTTE</b> Fraction <b>NW 1/4 NE 1/4 NE 1/4</b> Section number <b>23</b> Township number <b>T 10 S R 24</b> Range number <b>EW</b>	
2. Distance and direction from nearest town or city: <b>3 mi. N.W. from Lawrence City, KS</b> Street address of well location if in city: <b>NEARMAN POWER PLANT</b> 3. Owner of well: <b>MORETRENCH-AMERICAN</b> R.R. or street: <b>5200 KATRINE AVE</b> City, state, zip, code: <b>POUNERS GROVE, ILL, 60115</b>	
4. Locate with "X" in section below: Sketch map: 	
5. Type and color of material	
6. Bore hole dia. <b>1 1/2</b> in. Completion date <b>3-29-79</b> Well depth <b>26</b> ft.	
7. <input type="checkbox"/> Cable tool <input type="checkbox"/> Rotary <input type="checkbox"/> Driven <input type="checkbox"/> Dug <input checked="" type="checkbox"/> Hollow rod <input checked="" type="checkbox"/> Jetted <input type="checkbox"/> Bored <input type="checkbox"/> Reverse rotary	
8. Use: <input type="checkbox"/> Domestic <input type="checkbox"/> Public supply <input type="checkbox"/> Industry <input type="checkbox"/> Irrigation <input type="checkbox"/> Air conditioning <input type="checkbox"/> Stock <input type="checkbox"/> Lawn <input type="checkbox"/> Oil field water <input checked="" type="checkbox"/> Other	
9. Casing: Material <b>Steel</b> Height: Above or below Threaded <input checked="" type="checkbox"/> Welded <input type="checkbox"/> Surface <b>12</b> in. RMP <input type="checkbox"/> PVC <input type="checkbox"/> Weight <b>2.72</b> lbs./ft. Dia. <b>1 1/2</b> in. to <b>23</b> ft. depth Wall Thickness: inches or Dia. <input type="checkbox"/> in. to <input type="checkbox"/> ft. depth gage No. <b>40</b>	
10. Screen: Manufacturer's name <b>M-1-A</b> Type <b>MESH</b> Dia. <b>1 1/2</b> Slot/gauze <b>3</b> Length <b>3</b> Set between <b>23</b> ft. and <b>26</b> ft. <input type="checkbox"/> ft. and <input type="checkbox"/> ft. Gravel pack? <b>No</b> Size range of material <input type="checkbox"/>	
11. Static water level: <b>21</b> ft. below land surface Date <b>3-29-79</b> mo./day/yr.	
12. Pumping level below land surfaces: <input type="checkbox"/> ft. after <input type="checkbox"/> hrs. pumping <input type="checkbox"/> g.p.m. <input type="checkbox"/> ft. after <input type="checkbox"/> hrs. pumping <input type="checkbox"/> g.p.m. Estimated maximum yield <input type="checkbox"/> g.p.m.	
13. Water sample submitted: <input type="checkbox"/> Yes <input checked="" type="checkbox"/> No Date <input type="checkbox"/> mo./day/yr.	
14. Well head completion: <b>No</b> Pitless adapter <input type="checkbox"/> inches above grade	
15. Well grouted? <b>YES</b> With: <input type="checkbox"/> Neat cement <input checked="" type="checkbox"/> Bentonite <input type="checkbox"/> Concrete Depth: From <input type="checkbox"/> ft. to <input type="checkbox"/> ft.	
16. Nearest source of possible contamination: ft. <b>1000</b> Direction <b>N</b> Type <b>RIVER</b> Well disinfected upon completion? <input type="checkbox"/> Yes <input type="checkbox"/> No	
17. Pump: <input type="checkbox"/> Not installed Manufacturer's name <b>NONE</b> Model number <input type="checkbox"/> HP <input type="checkbox"/> Volts <input type="checkbox"/> Length of drop pipe <input type="checkbox"/> ft. capacity <input type="checkbox"/> g.p.m. Type: <input type="checkbox"/> Submersible <input type="checkbox"/> Turbine <input type="checkbox"/> Jet <input type="checkbox"/> Reciprocating <input type="checkbox"/> Centrifugal <input type="checkbox"/> Other	
(Use a second sheet if needed)	
18. Elevation: <b>752</b> Topography: <input type="checkbox"/> Hill <input type="checkbox"/> Slope <input type="checkbox"/> Upland <input checked="" type="checkbox"/> Valley	19. Remarks: <b>SET IN 10 WELLPOINTS AROUND MH #3 - MATERIAL FOR ALL WELLPOINTS UNIFORM</b>
20. Water well contractor's certification: This well was drilled under my jurisdiction and this report is true to the best of my knowledge and belief. <b>MORETRENCH-AMERICAN</b> Business name <b>POUNERS GROVE ILL</b> License No. <input type="checkbox"/> Address <input type="checkbox"/> Signed <b>D. Wegner</b> Date <b>3-29-79</b> Authorized representative	

T  
R  
W  
S  
10 240 23 NW 1/4

Forward the white, blue and pink copies to the Department of Health and Environment

Form WWC-5