MH #11

not in CP

USE TYPEWRITER OR BALL POINT PEN-PRESS FIRMLY, PRINT CLEARLY.

MH #11 Remove

WATER WELL RECORD

KSA 82a-1201-1215

Kansas Department of Health and Environment-Division of Environment
(Water well Cantractors)
Topeka, Kansas 66620

1. Location of well:	County	Fraction	Section number	Township number	Range number
	Wyandotte	NE 1/4 NE 1/4 NE 1/4	23	T 10 S	R 24 E/W

2. Distance and direction from nearest town or city: 3 MI N.W FROM KANSAS CITY, KS
Street address of well location if in city: NEARMAN POWER PLANT

3. Owner of well: MORETRENCH - AMERICAN
R.R. or street: 5200 KATRINE AVE
City, state, zip code: DOWNERS GROVE, ILL. 60515

4. Locate with "X" in section below:

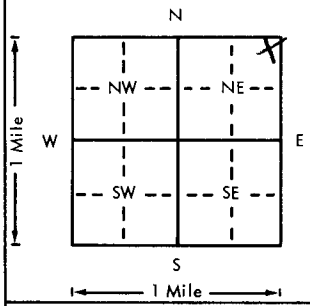

Sketch map:

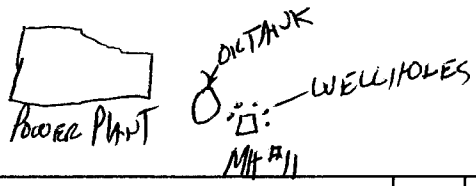

5. Type and color of material	From	To
Pull + Grout 5 WELLPOINT		
Holes With Western Bentonite		
From EL 736 to 752 - Surface		
EL 752		
(Use a second sheet if needed)		

6. Bore hole dia. 11½ in. Completion date 5-10-79
Well depth 26 ft.

7. __ Cable tool __ Rotary __ Driven __ Dug
__ Hollow rod X Jetted __ Bored __ Reverse rotary

8. Use: __ Domestic __ Public supply __ Industry
__ Irrigation __ Air conditioning __ Stock
__ Lawn __ Oil field water X Other

9. Casing: Material STEEL
Threaded X Welded ____
RMP ____ PVC ____
Dia 1½ in. to 23 ft. depth
Dia. ____ in. to ____ ft. depth
Height: Above or below Surface 12 in.
Weight 2.22 lbs./ft.
Wall Thickness: inches or gage No. 40

10. Screen: Manufacturer's name M.P.A.
Type MESH Dia. 1½
Slot/gauze ____ Length 3'
Set between 23 ft. and 26 ft.
____ ft. and ____ ft.
Gravel pack? No Size range of material ____

11. Static water level: mo./day/yr.
16 ft. below land surface Date 5-10-79

12. Pumping level below land surfaces:
____ ft. after ____ hrs. pumping ____ g.p.m.
____ ft. after ____ hrs. pumping ____ g.p.m.
Estimated maximum yield ____ g.p.m.

13. Water sample submitted: mo./day/yr.
__ Yes X No Date ____

14. Well head completion:
No Pitless adapter ____ Inches above grade

15. Well grouted? YES
With: ____ Neat cement X Bentonite ____ Concrete
Depth: From 0 ft. to 16 ft.

16. Nearest source of possible contamination:
ft. 1000 Direction N Type RIVER
Well disinfected upon completion? ____ Yes ____ No

17. Pump: Not installed
Manufacturer's name NONE
Model number ____ HP ____ Volts ____
Length of drop pipe ____ ft. capacity ____ g.p.m.
Type:
__ Submersible __ Turbine
__ Jet __ Reciprocating
__ Centrifugal __ Other

18. Elevation: 752
Topography:
__ Hill
__ Slope
__ Upland
X Valley

19. Remarks:

20. Water well contractor's certification:
This well was drilled under my jurisdiction and this report is true to the best of my knowledge and belief.
Business name MORETRENCH - AMERICAN License No. ____
Address DOWNERS GROVE ILL
Signed J. Widener Date 5-10-79
Authorized representative

T 10 R 24 E/W Sec 23 1/4 NE 1/4 NE 1/4 NE 1/4

Forward the white, blue and pink copies to the Department of Health and Environment

Form WWC-5

MI-1023