

MH#1 REMOVE

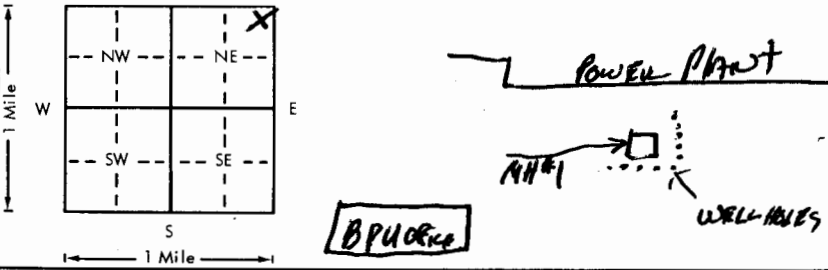
100 100 100

USE TYPEWRITER OR BALL POINT PEN-PRESS FIRMLY, PRINT CLEARLY.

MH #1 Remove

WATER WELL RECORD
KSA 82a-1201-1215

Kansas Department of Health and Environment-Division of Environment
(Water well Contractors)
Topeka, Kansas 66620

1. Location of well: County Wyandotte Fraction NE 1/4 NE 1/4 NE 1/4 Section number 23 Township number T 10 S R 24 Range number EW	
2. Distance and direction from nearest town or city: 3 mi NW from Kansas City, KS Street address of well location if in city: DEANMAN POWER PLANT 3. Owner of well: MORETECH-AMERICAN R.R. or street: 5200 KATRINE City, state, zip code: DOWNERS GROVE, ILL 60815	
4. Locate with "X" in section below: Sketch map: 	
6. Bore hole dia. 1 1/2 in. Completion date 7-17-79 Well depth 26 ft.	
7. <input type="checkbox"/> Cable tool <input type="checkbox"/> Rotary <input type="checkbox"/> Driven <input type="checkbox"/> Dug <input checked="" type="checkbox"/> Hollow rod <input checked="" type="checkbox"/> Jetted <input type="checkbox"/> Bored <input type="checkbox"/> Reverse rotary	
8. Use: <input type="checkbox"/> Domestic <input type="checkbox"/> Public supply <input type="checkbox"/> Industry <input type="checkbox"/> Irrigation <input type="checkbox"/> Air conditioning <input type="checkbox"/> Stock <input type="checkbox"/> Lawn <input type="checkbox"/> Oil field water <input checked="" type="checkbox"/> Other	
9. Casing: Material Steel Height: Above or below Threading <input checked="" type="checkbox"/> Welded <input type="checkbox"/> Surface 12 in. RMP <input type="checkbox"/> PVC <input type="checkbox"/> Weight 2.72 lbs./ft. Dia. 1 1/2 in. to 33 ft. depth Well Thickness: inches or Dia. <input type="checkbox"/> in. to <input type="checkbox"/> ft. depth Gauge No. 40	
5. Type and color of material From To	
Pull & Grout 10 WELL POINT HOLES Using WESTERN BENTONITE FROM EL 734 to 752 - GROUND SURFACE IS 752	
10. Screen: Manufacturer's name M-T-A Type MESH Dia. 1 1/2 Slot/gauze 3 Length 3 Set between 23 ft. and 26 ft. Gravel pack? No Size range of material	
11. Static water level: 28 ft. below land surface Date 8-7-13-79 mg./day/yr.	
12. Pumping level below land surfaces: _____ ft. after _____ hrs. pumping _____ g.p.m. Estimated maximum yield _____ g.p.m.	
13. Water sample submitted: _____ Yes <input checked="" type="checkbox"/> No _____ Date _____	
14. Well head completion: No Pitless adapter _____ Inches above grade	
15. Well grouted? YES With: <input checked="" type="checkbox"/> Neat cement <input checked="" type="checkbox"/> Bentonite _____ Concrete _____ Depth: From _____ ft. to _____ ft.	
16. Nearest source of possible contamination: _____ ft. 1000 Direction N Type RIVER Well disinfected upon completion? _____ Yes _____ No	
17. Pump: _____ Not installed Manufacturer's name NOPE Model number _____ HP _____ Volts _____ Length of drop pipe _____ ft. capacity _____ g.p.m. Type: _____ Submersible _____ Turbine _____ Jet _____ Reciprocating _____ Centrifugal _____ Other _____	
(Use a second sheet if needed)	
18. Elevation: 752 Topography: <input type="checkbox"/> Hill <input type="checkbox"/> Slope <input type="checkbox"/> Upland <input checked="" type="checkbox"/> Valley	19. Remarks:
20. Water well contractor's certification: This well was drilled under my jurisdiction and this report is true to the best of my knowledge and belief. Moretech - American Business name Downers Grove, Ill License No. _____ Address J. Wojcik Signed J. Wojcik Date 8-7-13-79 Authorized representative	

T
R
E
S
10 240 23 NE NE NE

Forward the white, blue and pink copies to the Department of Health and Environment

Form WWC-5