

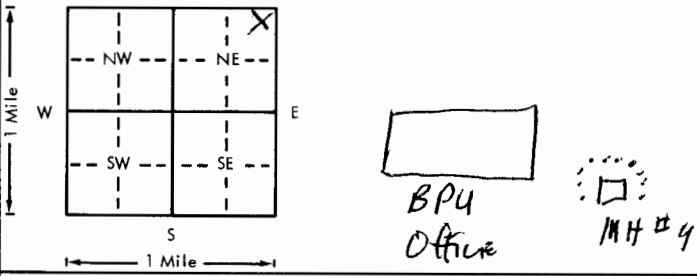
MH #9

NOB 01 25

USE TYPEWRITER OR BALL POINT PEN-PRESS FIRMLY, PRINT CLEARLY.

MH #9 Remove WATER WELL RECORD KSA 82a-1201-1215

Kansas Department of Health and Environment-Division of Environment (Water well Contractors) Topeka, Kansas 66620

1. Location of well: County <u>Wyandotte</u> Fraction <u>NE 1/4 NE 1/4 NE 1/4</u> Section number <u>D3</u> Township number <u>T 10</u> Range number <u>S R 24</u> <u>ENW</u>	
2. Distance and direction from nearest town or city: <u>3 MI N.W. FROM KANSAS CITY, KS</u> Street address of well location if in city: <u>NEAR MAN POWER PLANT</u>	
3. Owner of well: <u>MOETRENCH-AMERICAN</u> R.R. or street: <u>5200 PATRIOT AVE</u> City, state, zip code: <u>POWERS GROVE 10 605K</u>	
4. Locate with "X" in section below: Sketch map: 	
5. Type and color of material	
6. Bore hole dia. <u>1 1/2</u> in. Completion date <u>9-10-74</u> Well depth <u>26</u> ft.	
7. <input type="checkbox"/> Cable tool <input type="checkbox"/> Rotary <input type="checkbox"/> Driven <input type="checkbox"/> Dug <input type="checkbox"/> Hollow rod <input checked="" type="checkbox"/> Jetted <input type="checkbox"/> Bored <input type="checkbox"/> Reverse rotary	
8. Use: <input type="checkbox"/> Domestic <input type="checkbox"/> Public supply <input type="checkbox"/> Industry <input type="checkbox"/> Irrigation <input type="checkbox"/> Air conditioning <input type="checkbox"/> Stock <input type="checkbox"/> Lawn <input type="checkbox"/> Oil field water <input checked="" type="checkbox"/> Other	
9. Casing: Material <u>Steel</u> Height: Above or below Threading <input checked="" type="checkbox"/> Welded <input type="checkbox"/> Surface <u>12</u> in. RMP <input type="checkbox"/> PVC <input type="checkbox"/> Weight <u>2.72</u> lbs./ft. Dia. <u>1 1/2</u> in. to <u>23</u> ft. depth; Wall Thickness: inches or Dia. <u>   </u> in. to <u>   </u> ft. depth; gage No. <u>40</u>	
10. Screen: Manufacturer's name <u>MTH</u> Type <u>MESH</u> Dia. <u>1 1/2</u> Slot/gauze <u>   </u> Length <u>   </u> Set between <u>23</u> ft. and <u>26</u> ft. Gravel pack? <u>No</u> Size range of material <u>   </u>	
11. Static water level: <u>22</u> ft. below land surface Date <u>9-10-74</u> mo./day/yr.	
12. Pumping level below land surfaces: <u>   </u> ft. after <u>   </u> hrs. pumping <u>   </u> g.p.m. Estimated maximum yield <u>   </u> g.p.m.	
13. Water sample submitted: <u>   </u> mo./day/yr. Yes <input type="checkbox"/> No <input checked="" type="checkbox"/> Date <u>   </u>	
14. Well head completion: <u>No</u> Pitless adapter <u>   </u> Inches above grade	
15. Well grouted? <u>Yes</u> With: <u>   </u> Neat cement <u>   </u> Bentonite <u>   </u> Concrete Depth: From <u>0</u> ft. to <u>22</u> ft.	
16. Nearest source of possible contamination: ft. <u>1000</u> Direction <u>N</u> Type <u>RIVER</u> Well disinfected upon completion? Yes <input type="checkbox"/> No <input checked="" type="checkbox"/>	
17. Pump: Not installed Manufacturer's name <u>Power</u> Model number <u>   </u> HP <u>   </u> Volts <u>   </u> Length of drop pipe <u>   </u> ft. capacity <u>   </u> g.p.m. Type: <input type="checkbox"/> Submersible <input type="checkbox"/> Turbine <input type="checkbox"/> Jet <input type="checkbox"/> Reciprocating <input type="checkbox"/> Centrifugal <input type="checkbox"/> Other	
(Use a second sheet if needed)	
18. Elevation: <u>792</u> Topography: <input type="checkbox"/> Hill <input type="checkbox"/> Slope <input type="checkbox"/> Upland <input checked="" type="checkbox"/> Valley	19. Remarks:
20. Water well contractor's certification: This well was drilled under my jurisdiction and this report is true to the best of my knowledge and belief. Business name <u>MOETRENCH-AMERICAN</u> License No. <u>   </u> Address <u>POWERS GROVE 10</u> Signed <u>J. W. Wagoner</u> Date <u>9-10-74</u> Authorized representative	

T 10 R 24 S 23 NE 1/4 NE 1/4

Forward the white, blue and pink copies to the Department of Health and Environment

Form WWC-5