


1 LOCATION OF WATER WELL: Fraction SW 1/4 SE 1/4 SE 1/4 Section Number 14 Township Number T 10 S Range Number R 24 EW
 County: Wyandotte

Distance and direction from nearest town or city street address of well if located within city?
North of Nearman Creek Generating Station Along Southern Bank of Missouri River

2 WATER WELL OWNER: Board of Public Utilities
 RR#, St. Address, Box #: 1211 N. 8th Street Board of Agriculture, Division of Water Resources
 City, State, ZIP Code: Kansas City, KS 66101 Application Number:

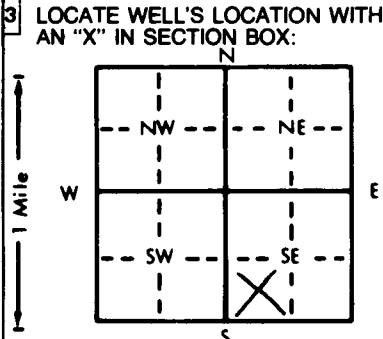

4 DEPTH OF COMPLETED WELL: 60 ft. ELEVATION:
 Depth(s) Groundwater Encountered 1. 14.7 ft. 2. ft. 3. ft.
 WELL'S STATIC WATER LEVEL 19.7 ft. below land surface measured on mo/day/yr 11/14/94
 Pump test data: Well water was ft. after hours pumping gpm
 Est. Yield gpm: Well water was ft. after hours pumping gpm
 Bore Hole Diameter: 7 in. to 7.5 in. to ft. and in. to ft.
 WELL WATER TO BE USED AS:
 5 Public water supply 8 Air conditioning 11 Injection well
 1 Domestic 3 Feedlot 6 Oil field water supply 9 Dewatering 12 Other (Specify below)
 2 Irrigation 4 Industrial 7 Lawn and garden only 10 Monitoring well
 Was a chemical/bacteriological sample submitted to Department? Yes (No); If yes, mo/day/yr sample was submitted
 Water Well Disinfected? Yes No

5 TYPE OF BLANK CASING USED:
 1 Steel 3 RMP (SR) 5 Wrought iron 8 Concrete tile CASING JOINTS: Glued Clamped
2 PVC 4 ABS 6 Asbestos-Cement 9 Other (specify below) Welded
 7 Fiberglass Threaded
 Blank casing diameter 4 in. to 60 ft., Dia. in. to ft., Dia. in. to ft.
 Casing height above land surface: Approx. 24 in., weight lbs./ft. Wall thickness or gauge No. SCH 40
 TYPE OF SCREEN OR PERFORATION MATERIAL:
 1 Steel 3 Stainless steel 5 Fiberglass 8 RMP (SR) 10 Asbestos-cement 11 Other (specify)
 2 Brass 4 Galvanized steel 6 Concrete tile 9 ABS 12 None used (open hole)
 SCREEN OR PERFORATION OPENINGS ARE:
1 Continuous slot .020" 3 Mill slot 5 Gauzed wrapped 8 Saw cut 11 None (open hole)
 2 Louvered shutter 4 Key punched 6 Wire wrapped 9 Drilled holes
 7 Torch cut 10 Other (specify)
 SCREEN-PERFORATED INTERVALS: From 50 ft. to 60 ft., From ft. to ft.
 From ft. to ft., From ft. to ft.
 GRAVEL PACK INTERVALS: From NONE ft. to ft., From ft. to ft.
 From ft. to ft., From ft. to ft.

6 GROUT MATERIAL: 1 Neat cement 2 Cement grout 3 Bentonite 4 Other
 Grout Intervals: From 48 ft. to GRADE ft., From ft. to ft., From ft. to ft.
 What is the nearest source of possible contamination:
 1 Septic tank 4 Lateral lines 7 Pit privy 10 Livestock pens 14 Abandoned water well
 2 Sewer lines 5 Cess pool 8 Sewage lagoon 11 Fuel storage 15 Oil well/Gas well
 3 Watertight sewer lines 6 Seepage pit 9 Feedyard 12 Fertilizer storage 16 Other (specify below)
 13 Insecticide storage
 Direction from well? How many feet?

FROM	TO	LITHOLOGIC LOG	FROM	TO	PLUGGING INTERVALS
0	3	Top Soil, Brown	0	48	Cement Grout
3	8	Silty Clay, Grey	48	50	Bentonite Seal
8	15	Sandy Silt, Brown	50	60	SCREEN
15	20	Fine Silty Sand, Grey	60	75	Natural Materials
20	50	Fine-med. Silty Sand, Grey			
50	54	Med.-Cs. Sand, Med. Silt, Grey			
54	61	Sand, Scat. Fine Gravel and Clay Balls			
61	68	Clay and Gravel - Drilled			
68	75	Fine-Med. Sand w/ Heavy Silt			
		<u>MONITORING WELL 1</u>			

7 CONTRACTOR'S OR LANDOWNER'S CERTIFICATION: This water well was (1) constructed, (2) reconstructed, or (3) plugged under my jurisdiction and was completed on (mo/day/year) 11/15/94 and this record is true to the best of my knowledge and belief. Kansas Water Well Contractor's License No. 5778 This Water Well Record was completed on (mo/day/yr) 12/5/94 under the business name of Ranney Division, Hydro Group, Inc. by (signature) Michael J. Shea

OFFICE USE ONLY
T
R
EW
SEC.
1/4
1/4
1/4