


<b>1</b> LOCATION OF WATER WELL:	Fraction	Section Number	Township Number	Range Number
County: <b>Wyandotte</b>	<b>SE ¼ NE ¼ NE ¼</b>	<b>34</b>	<b>T 10 S</b>	<b>R 25 <u>E/W</u></b>

Distance and direction from nearest town or city street address of well if located within city?

**2000' E & 800' N Intersection Fairfax & Manley Rd.**

**2** WATER WELL OWNER: **Williams Pipeline Company**  
 RR#, St. Address, Box #: **8001 College Blvd., Ste 200**  
 City, State, ZIP Code: **Overland Park, KS 66210**  
 Board of Agriculture, Division of Water Resources  
 Application Number:

**3** LOCATE WELL'S LOCATION WITH AN "X" IN SECTION BOX:

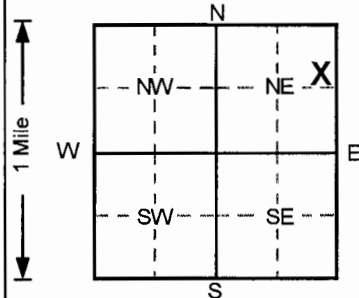

**4** DEPTH OF COMPLETED WELL **15** ft. ELEVATION: ..... ft.

Depth(s) Groundwater Encountered 1. .... ft. 2. .... ft. 3. .... ft.

WELL'S STATIC WATER LEVEL **13.4** ft. below land surface measured on mo/day/yr **9/15/95**

Pump test data: Well water was **NA** ft. after ..... hours pumping ..... gpm  
 Est. Yield **NA** gpm: Well water was ..... ft. after ..... hours pumping ..... gpm  
 Bore Hole Diameter **8.25** in. to **15** ft., and ..... in. to ..... ft.

WELL WATER TO BE USED AS: 5 Public water supply 8 Air conditioning 11 Injection well  
 1 Domestic 3 Feedlot 6 Oil field water supply 9 Dewatering **12 Other (Specify below)**  
**Soil Vapor**  
 2 Irrigation 4 Industrial 7 Lawn and garden only 10 Monitoring well  
 Was a chemical/bacteriological sample submitted to Department? Yes.....No  .....; If yes, mo/day/yr sample was submitted  
 Water Well Disinfected? Yes No

**5** TYPE OF CASING USED: 5 Wrought iron 8 Concrete tile CASING JOINTS: Glued ..... Clamped .....  
 1 Steel 3 RMP (SR) 6 Asbestos-Cement 9 Other (specify below) Welded .....  
 2 PVC 4 ABS 7 Fiberglass Threaded.

Blank casing diameter **2** in. to **4.5** ft., Dia ..... in. to ..... ft., Dia ..... in. to ..... ft.  
 Casing height above land surface **0** in., weight ..... lbs./ft. Wall thickness or gauge No. **Sch. 40**

TYPE OF SCREEN OR PERFORATION MATERIAL **7** PVC 10 Asbestos-cement  
 1 Steel 3 Stainless steel 5 Fiberglass 8 RMP (SR) 11 Other (specify) .....  
 2 Brass 4 Galvanized steel 6 Concrete tile 9 ABS 12 None used (open hole)

SCREEN OR PERFORATION OPENINGS ARE: 5 Gauzed wrapped 8 Saw cut 11 None (open hole)  
 1 Continuous slot  3 Mill slot 6 Wire wrapped 9 Drilled holes  
 2 Louvered shutter 4 Key punched 7 Torch cut 10 Other (specify) .....

SCREEN-PERFORATED INTERVALS: From **4.5** ft. to **15** ft., From ..... ft. to ..... ft.  
 From ..... ft. to ..... ft., From ..... ft. to ..... ft.

GRAVEL PACK INTERVALS: From **4.5** ft. to **15** ft., From ..... ft. to ..... ft.  
 From ..... ft. to ..... ft., From ..... ft. to ..... ft.

**6** GROUT MATERIAL: 1 Neat cement  2 Cement grout  3 Bentonite 4 Other .....  
 Grout Intervals: From **0** ft. to **0.5** ft., From **0.5** ft. to **4.5** ft., From ..... ft. to ..... ft.

What is the nearest source of possible contamination:  
 1 Septic tank 4 Lateral lines 7 Pit privy 10 Livestock pens 14 Abandoned water well  
 2 Sewer lines 5 Cess pool 8 Sewage lagoon 11 Fuel storage 15 Oil well/Gas well  
 3 Watertight sewer lines 6 Seepage pit 9 Feedyard 12 Fertilizer storage **16 Other (specify below)**  
**Overfill**  
 Direction from well? **W** How many feet? **50**

FROM	TO	LITHOLOGIC LOG	FROM	TO	PLUGGING INTERVALS
0	4	<b>Gravel,</b>			
4	6	<b>Clay, Black</b>			
6	9	<b>Clay, Greenish Gray</b>			
9	15	<b>Sand, Gray</b>			
					<b>SVEP, Flushmount</b>
					<b>Project Name: Delta - Williams</b>
					<b>GeoCore # 259, Delta # A194-063</b>

**7** CONTRACTOR'S OR LANDOWNER'S CERTIFICATION: This water well was  (1) constructed, (2) reconstructed, or (3) plugged under my jurisdiction and was completed on (mo/day/year) **9/13/95** and this record is true to the best of my knowledge and belief.  
 Kansas Water Well Contractor's License No. **527** This Water Well Record was completed on (mo/day/yr) **10/12/95**  
 under the business name of **GeoCore Services, Inc.** by (signature) *Rob Rob*