


02968009

1 LOCATION OF WATER WELL: Fraction **NW 1/4 NE 1/4 SE 1/4** Section Number **34** Township Number **T 10 S** Range Number **R 25 E**
 County: **WYANDOTTE**

Distance and direction from nearest town or city street address of well if located within city?
2851 FAIRFAX K.C., KS

2 WATER WELL OWNER: **PHILLIPS PETROLEUM COMPANY** MW-3
 RR#, St. Address, Box #: **13 B1 PHILLIPS BLDG**
 City, State, ZIP Code: **BARTLESVILLE, OK 74004**
 Board of Agriculture, Division of Water Resources
 Application Number:

3 LOCATE WELL'S LOCATION WITH AN "X" IN SECTION BOX:

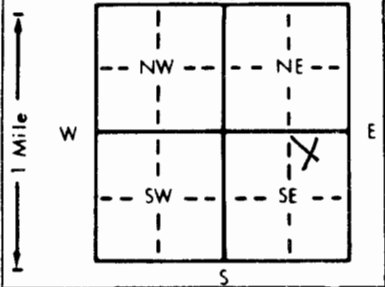

4 DEPTH OF COMPLETED WELL: **29.0** ft. ELEVATION:
 Depth(s) Groundwater Encountered 1. **18.0** ft. 2. ft. 3. ft.
 WELL'S STATIC WATER LEVEL **18.0** ft. below land surface measured on mo/day/yr
 Pump test data: Well water was ft. after hours pumping gpm
 Est. Yield gpm: Well water was ft. after hours pumping gpm
 Bore Hole Diameter: **8.25** in. to **29.0** ft. and in. to ft.
 WELL WATER TO BE USED AS:
 5 Public water supply 8 Air conditioning 11 Injection well
 1 Domestic 3 Feedlot 6 Oil field water supply 9 De-aerating 12 Other (Specify below)
 2 Irrigation 4 Industrial 7 Lawn and garden only 10 Monitoring well
 Was a chemical/bacteriological sample submitted to Department? Yes No If yes, mo/day/yr sample was submitted
 Water Well Disinfected? Yes No

5 TYPE OF BLANK CASING USED:
 1 Steel 3 RMP (SR) 5 Wrought iron 8 Concrete tile CASING JOINTS: Glued Clamped
 2 PVC 4 ABS 6 Asbestos-Cement 9 Other (specify below) Welded
 7 Fiberglass Threaded
 Blank casing diameter **2** in. to **14.0** ft. Dia in. to ft. Dia in. to ft.
 Casing height above land surface **3** in., weight lbs./ft. Wall thickness or gauge No. **SCHED 40**

TYPE OF SCREEN OR PERFORATION MATERIAL:
 1 Steel 3 Stainless steel 5 Fiberglass 8 RMP (SR) 10 Asbestos-cement
 2 Brass 4 Galvanized steel 6 Concrete tile 9 ABS 11 Other (specify)
 12 None used (open hole)

SCREEN OR PERFORATION OPENINGS ARE:
 1 Continuous slot 3 Mill slot **0.010** 5 Gauzed wrapped 8 Saw cut 11 None (open hole)
 2 Louvered shutter 4 Key punched 6 Wire wrapped 9 Drilled holes
 7 Torch cut 10 Other (specify)

SCREEN-PERFORATED INTERVALS: From **14.0** ft. to **29.0** ft. From ft. to ft.
 From ft. to ft. From ft. to ft.
 GRAVEL PACK INTERVALS: From **10.5** ft. to **29.0** ft. From ft. to ft.
 From ft. to ft. From ft. to ft.

6 GROUT MATERIAL:
 1 Neat cement 2 Cement grout 3 Bentonite 4 Other **CONCRETE**
 Grout Interval: 3 From **10.5** ft. to **4.0** ft. 2 From **4.0** ft. to **1.0** ft. 4 From **1.0** ft. to **+0.5** ft.
 What is the nearest source of possible contamination:
 1 Septic tank 4 Lateral lines 7 Pit privy 11 Fuel storage 14 Abandoned water well
 2 Sewer lines 5 Cess pool 8 Sewage lagoon 12 Fertilizer storage 15 Oil well/Gas well
 3 Watertight sewer lines 6 Seepage pit 9 Feedyard 13 Insecticide storage 16 Other (specify below)
 Direction from well? **S.** How many feet? **100**

FROM	TO	LITHOLOGIC LOG	FROM	TO	PLUGGING INTERVALS
0.0	8.0	CLAY DRN SILTY			
8.0	12.0	CLAY DLK SILTY PETRO.			
12.0	29.0	SILT + SAND FINE TO VERY FINE GRAY PETRO. ODOR			

7 CONTRACTOR'S OR LANDOWNER'S CERTIFICATION: This water well was constructed, (2) reconstructed, or (3) plugged under my jurisdiction and was completed on (mo/day/year) **5-21-96** and this record is true to the best of my knowledge and belief. Kansas Water Well Contractor's License No. **416** This Water Well Record was completed on (mo/day/yr) **6-13-96** under the business name of **TERRACON CONSULTANTS INC** by (signature) **Clay O. Wray**