


1 LOCATION OF WATER WELL: County: **WYANDOTTE** Fraction: **SW 1/4 SW 1/4 SW 1/4** Section Number: **27** Township Number: **T 10 S** Range Number: **R 25 @W**

Distance and direction from nearest town or city street address of well if located within city? **INSIDE BUILDING**
3126 BRINKERHOFF, KANSAS CITY, KS

2 WATER WELL OWNER: **UNISON** **PF-2**
 RR#, St. Address, Box #: **3126 BRINKERHOFF** Board of Agriculture, Division of Water Resources
 City, State, ZIP Code: **KANSAS CITY KS** Application Number:

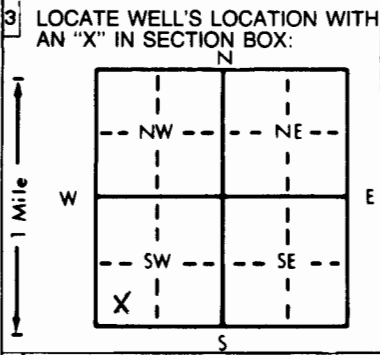

4 DEPTH OF COMPLETED WELL: **38.0** ft. ELEVATION:
 Depth(s) Groundwater Encountered 1. ft. 2. ft. 3. ft.
 WELL'S STATIC WATER LEVEL ft. below land surface measured on mo/day/yr
 Pump test data: Well water was ft. after hours pumping gpm
 Est. Yield gpm: Well water was ft. after hours pumping gpm
 Bore Hole Diameter: **11** in. to **11** ft., and **4 1/2** in. to **39** ft.
 WELL WATER TO BE USED AS:
 1 Domestic 3 Feedlot 6 Oil field water supply 9 Dewatering **12 Other (Specify below)**
 2 Irrigation 4 Industrial 7 Lawn and garden only 10 Monitoring well **FRACTURE**
 Was a chemical/bacteriological sample submitted to Department? Yes No; If yes, mo/day/yr sample was submitted
 Water Well Disinfected? Yes No

5 TYPE OF BLANK CASING USED:
 ① Steel 3 RMP (SR) 5 Wrought iron 8 Concrete tile CASING JOINTS: Glued Clamped
 ② PVC ④ ABS 6 Asbestos-Cement 9 Other (specify below) Welded
 7 Fiberglass ② 4 Threaded.
 Blank casing diameter: **8** in. to **11** ft., Dia **4** in. to **13** ft., Dia in. to ft.
 Casing height above land surface: **2.0** in., weight lbs./ft. Wall thickness or gauge No. **SCHED. 40**
 TYPE OF SCREEN OR PERFORATION MATERIAL:
 1 Steel ③ Stainless steel 5 Fiberglass 8 RMP (SR) 10 Asbestos-cement 11 Other (specify)
 2 Brass 4 Galvanized steel 6 Concrete tile 9 ABS 12 None used (open hole)
 SCREEN OR PERFORATION OPENINGS ARE:
 1 Continuous slot 3 Mill slot ⑥ Wire wrapped **0.010"** 8 Saw cut 11 None (open hole)
 2 Louvered shutter 4 Key punched 7 Torch cut 9 Drilled holes
 SCREEN-PERFORATED INTERVALS: From **13.0** ft. to **38.0** ft., From ft. to ft.
 From ft. to ft., From ft. to ft.
 GRAVEL PACK INTERVALS: From ft. to ft., From ft. to ft.
 From ft. to ft., From ft. to ft.

6 GROUT MATERIAL: ③ Neat cement 2 Cement grout ③ Bentonite ④ Other
 Grout Intervals: From **13.0** ft. to **11.0** ft., From **11.0** ft. to **0.0** ft., From ft. to ft.
 What is the nearest source of possible contamination:
 1 Septic tank 4 Lateral lines 7 Pit privy 10 Livestock pens 14 Abandoned water well
 2 Sewer lines 5 Cess pool 8 Sewage lagoon 11 Fuel storage 15 Oil well/Gas well
 3 Watertight sewer lines 6 Seepage pit 9 Feedyard 12 Fertilizer storage **16 Other (specify below)**
 13 Insecticide storage **INDUSTRIAL SITE**
 Direction from well? How many feet? **0**

FROM	TO	LITHOLOGIC LOG	FROM	TO	PLUGGING INTERVALS
0.0	1.0	BR. FINE SAND, SILT, CLAY (M)			
1.0	7.0	BR CHAY (CL)			
7.0	11.0	DARK BR. CLAY (CL)			
11.0	18.0	SILTY SAND (SC)			
18.0	39.0	FINE SAND (SM)			

7 CONTRACTOR'S OR LANDOWNER'S CERTIFICATION: This water well was ① constructed, (2) reconstructed, or (3) plugged under my jurisdiction and was completed on (mo/day/year) **7-10-96** and this record is true to the best of my knowledge and belief. Kansas Water Well Contractor's License No. **416** This Water Well Record was completed on (mo/day/yr) **8-20-96** under the business name of **TERRACON CONSULTANTS INC** by (signature) **Clay P. Day**