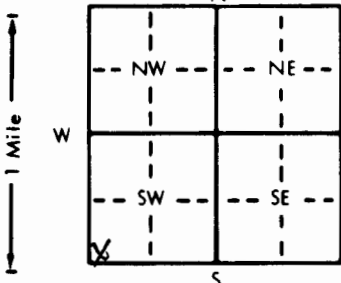


1 LOCATION OF WATER WELL: Fraction SW 1/4 SW 1/4 SW 1/4 Section Number 27 Township Number T 10 S Range Number R 25 **EW**
 County: **WYANDOTTE**

Distance and direction from nearest town or city street address of well if located within city?
3126 BRINKERHOFF KANSAS CITY KS

2 WATER WELL OWNER: **UNLSON** PF-11
 RR#, St. Address, Box #: **3126 BRINKERHOFF** Board of Agriculture, Division of Water Resources
 City, State, ZIP Code: **KANSAS CITY KS** Application Number:

3 LOCATE WELL'S LOCATION WITH AN "X" IN SECTION BOX:


4 DEPTH OF COMPLETED WELL: **52.0** ft. ELEVATION:
 Depth(s) Groundwater Encountered 1. ft. 2. ft. 3. ft.
 WELL'S STATIC WATER LEVEL ft. below land surface measured on mo/day/yr
 Pump test data: Well water was ft. after hours pumping gpm
 Est. Yield gpm: Well water was ft. after hours pumping gpm
 Bore Hole Diameter: **11** in. to **11** ft., and **4.25** in. to **55.0** ft.
 WELL WATER TO BE USED AS:
 1 Domestic 3 Feedlot 6 Oil field water supply 9 Dewatering Other (Specify below) **FRACTURE**
 2 Irrigation 4 Industrial 7 Lawn and garden only 10 Monitoring well
 Was a chemical/bacteriological sample submitted to Department? Yes No ; If yes, mo/day/yr sample was sub-
 mitted Water Well Disinfected? Yes No

5 TYPE OF BLANK CASING USED:
 Steel 3 RMP (SR) 6 Asbestos-Cement 9 Other (specify below) Welded
 2 PVC 4 ABS 7 Fiberglass Threaded
 Blank casing diameter **6** in. to **10.5** ft., Dia **4** in. to **11.8** ft., Dia in. to ft.
 Casing height above land surface in., weight lbs./ft. Wall thickness or gauge No.
 TYPE OF SCREEN OR PERFORATION MATERIAL:
 1 Steel Stainless steel 5 Fiberglass 8 RMP (SR) 11 Other (specify)
 2 Brass 4 Galvanized steel 6 Concrete tile 9 ABS 12 None used (open hole)
 SCREEN OR PERFORATION OPENINGS ARE:
 1 Continuous slot 3 Mill slot Wire wrapped **0.010"** 9 Drilled holes
 2 Louvered shutter 4 Key punched 7 Torch cut 10 Other (specify)
 SCREEN-PERFORATED INTERVALS: From **11.8** ft. to **52.0** ft., From ft. to ft.
 From ft. to ft., From ft. to ft.
 GRAVEL PACK INTERVALS: From **11.2** ft. to **11.8** ft., From ft. to ft.
 From ft. to ft., From ft. to ft.

6 GROUT MATERIAL: 1 Neat cement Cement grout Bentonite 4 Other
 Grout Intervals: From **0** ft. to **10.5** ft., From **10.5** ft. to **11.2** ft., From ft. to ft.
 What is the nearest source of possible contamination:
 1 Septic tank 4 Lateral lines 7 Pit privy 11 Fuel storage 14 Abandoned water well
 2 Sewer lines 5 Cess pool 8 Sewage lagoon 12 Fertilizer storage 15 Oil well/Gas well
 3 Watertight sewer lines 6 Seepage pit 9 Feedyard 13 Insecticide storage Other (specify below) **INDUSTRIAL SITE**

Direction from well?		LITHOLOGIC LOG	PLUGGING INTERVALS	
FROM	TO		FROM	TO
0	3"	ASPHALT		
3"	1.0	SAND-GRAVEL FILL		
1.0	10.0	BRN CLAY		
10.0	22.0	LT BRN CLAY		
22.0	30.0	BRN CLAY-SILT-SAND		
30.0	55.0	GRAY SAND		

7 CONTRACTOR'S OR LANDOWNER'S CERTIFICATION: This water well was constructed, (2) reconstructed, or (3) plugged under my jurisdiction and was completed on (mo/day/year) **11-5-96** and this record is true to the best of my knowledge and belief. Kansas Water Well Contractor's License No. **416** This Water Well Record was completed on (mo/day/yr) **1-5-97** under the business name of **TERRACON CONSULTANTS INC** by (signature) **Clay P. Oyer**