


1 LOCATION OF WATER WELL: Fraction SW 1/4 SW 1/4 SW 1/4 Section Number 27 Township Number T 10 S Range Number R 25 @/W  
 County: WYANDOTTE

Distance and direction from nearest town or city street address of well if located within city?  
3126 BRINKERHOFF, KANSAS CITY, KS

2 WATER WELL OWNER: UNISON PF-3  
 RR#, St. Address, Box #: 3126 BRINKERHOFF Board of Agriculture, Division of Water Resources  
 City, State, ZIP Code: KANSAS CITY KS Application Number:

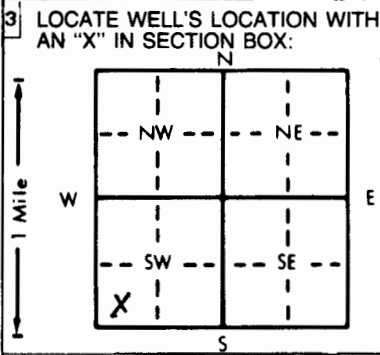

4 DEPTH OF COMPLETED WELL 46.6 ft. ELEVATION:  
 Depth(s) Groundwater Encountered 1. . . . . ft. 2. . . . . ft. 3. . . . . ft.  
 WELL'S STATIC WATER LEVEL . . . . . ft. below land surface measured on mo/day/yr  
 Pump test data: Well water was . . . . . ft. after . . . . . hours pumping . . . . . gpm  
 Est. Yield . . . . . gpm: Well water was . . . . . ft. after . . . . . hours pumping . . . . . gpm  
 Bore Hole Diameter: 11 in. to 11 ft., and 4.25 in. to 52.3 ft.  
 WELL WATER TO BE USED AS:  
 5 Public water supply 8 Air conditioning 11 Injection well  
 1 Domestic 3 Feedlot 6 Oil field water supply 9 Dewatering 12 Other (Specify below)  
 2 Irrigation 4 Industrial 7 Lawn and garden only 10 Monitoring well FRACTURE  
 Was a chemical/bacteriological sample submitted to Department? Yes . . . . . No ; If yes, mo/day/yr sample was submitted  
 Water Well Disinfected? Yes . . . . . No

5 TYPE OF BLANK CASING USED:  
 Steel 3 RMP (SR) 5 Wrought iron 8 Concrete tile CASING JOINTS: Glued . . . . . Clamped . . . . .  
 PVC 4 ABS 6 Asbestos-Cement 9 Other (specify below) Welded . . . . .  
 7 Fiberglass Threaded   
 Blank casing diameter 6 in. to 10.5 ft., Dia 7 in. to 12 ft., Dia . . . . . in. to . . . . . ft.  
 Casing height above land surface 6 in., weight . . . . . lbs./ft. Wall thickness or gauge No. SCHED 40  
 TYPE OF SCREEN OR PERFORATION MATERIAL:  
 Steel  Stainless steel 5 Fiberglass 8 RMP (SR) 10 Asbestos-cement  
 2 Brass 4 Galvanized steel 6 Concrete tile 9 ABS 11 Other (specify) . . . . .  
 12 None used (open hole)  
 SCREEN OR PERFORATION OPENINGS ARE:  
 1 Continuous slot 3 Mill slot  Wire wrapped 0.010" 8 Saw cut 11 None (open hole)  
 2 Louvered shutter 4 Key punched 7 Torch cut 9 Drilled holes  
 10 Other (specify) . . . . .  
 SCREEN-PERFORATED INTERVALS: From 12.0 ft. to . . . . . ft., From . . . . . ft. to . . . . . ft.  
 From . . . . . ft. to . . . . . ft., From . . . . . ft. to . . . . . ft.  
 GRAVEL PACK INTERVALS: From 11.4 ft. to . . . . . ft., From . . . . . ft. to . . . . . ft.  
 From . . . . . ft. to . . . . . ft., From . . . . . ft. to . . . . . ft.

6 GROUT MATERIAL: 1 Neat cement 2 Cement grout 3 Bentonite 4 Other . . . . .  
 Grout Intervals  From 0.0 ft. to 19.5 ft.,  From 19.5 ft. to 11.4 ft., From . . . . . ft. to . . . . . ft.  
 What is the nearest source of possible contamination:  
 1 Septic tank 4 Lateral lines 7 Pit privy 10 Livestock pens 14 Abandoned water well  
 2 Sewer lines 5 Cess pool 8 Sewage lagoon 11 Fuel storage 15 Oil well/Gas well  
 3 Watertight sewer lines 6 Seepage pit 9 Feedyard 12 Fertilizer storage 16 Other (specify below)  
INDUSTRIAL SITE  
 Direction from well? How many feet?

| FROM | TO   | LITHOLOGIC LOG                | FROM | TO | PLUGGING INTERVALS |
|------|------|-------------------------------|------|----|--------------------|
| 0    | 10.0 | LT. BRN CLAY                  |      |    |                    |
| 10.0 | 25.0 | LT. BRN CHAY - SILT           |      |    |                    |
| 25.0 | 27.0 | L+BRN - BRN CLAY SILT F. SAND |      |    |                    |
| 27.0 | 52.3 | GRAY F. SAND                  |      |    |                    |

7 CONTRACTOR'S OR LANDOWNER'S CERTIFICATION: This water well was  constructed, (2) reconstructed, or (3) plugged under my jurisdiction and was completed on (mo/day/year) 11-5-96 and this record is true to the best of my knowledge and belief. Kansas Water Well Contractor's License No. 416 This Water Well Record was completed on (mo/day/yr) 1-5-97 under the business name of TERRACON CONSULTANTS by (signature) Clay P. Wye