


1 LOCATION OF WATER WELL: County: Wyandotte Fraction NE 1/4 NE 1/4 NE 1/4 Section Number 34 Township Number T 10 S Range Number R 25 EW

Distance and direction from nearest town or city street address of well if located within city? 900' southeast of office, 401 Donovan Rd., Kansas City, KS 66115

2 WATER WELL OWNER: Williams Pipe Line Company, Attn: John Nanchertsen RR#, St. Address, Box #: 8001 College Blvd., Suite 200 City, State, ZIP Code: Kansas City, KS 66210 Board of Agriculture, Division of Water Resources Application Number:

3 LOCATE WELL'S LOCATION WITH AN "X" IN SECTION BOX:

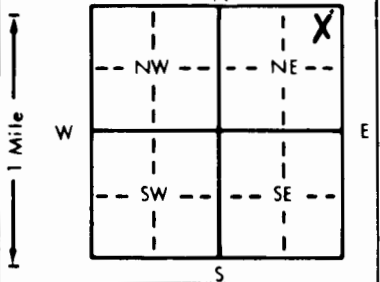

4 DEPTH OF COMPLETED WELL: 50 ft. ELEVATION: Depth(s) Groundwater Encountered 1. 1.5 ft. 2. ft. 3. ft. WELL'S STATIC WATER LEVEL 10.28 ft. below land surface measured on mo/day/yr 5/9/97 Pump test data: Well water was ft. after hours pumping gpm Est. Yield gpm Well water was ft. after hours pumping gpm Bore Hole Diameter 8 1/4 in. to 50 ft. and in. to ft. WELL WATER TO BE USED AS: 5 Public water supply 8 Air conditioning 11 Injection well 1 Domestic 3 Feedlot 6 Oil field water supply 9 Dewatering 12 Other (Specify below) 2 Irrigation 4 Industrial 7 Lawn and garden only 10 Monitoring well Was a chemical/bacteriological sample submitted to Department? Yes No; If yes, mo/day/yr sample was submitted Water Well Disinfected? Yes No

5 TYPE OF BLANK CASING USED: 1 Steel 3 RMP (SR) 5 Wrought iron 8 Concrete tile CASING JOINTS: Glued Clamped 2 PVC 4 ABS 6 Asbestos-Cement 9 Other (specify below) Welded Threaded Blank casing diameter 2 in. to 47.5 ft. Dia in. to ft. Dia in. to ft. Casing height above land surface 36 in. weight lbs./ft. Wall thickness or gauge No. TYPE OF SCREEN OR PERFORATION MATERIAL: 1 Steel 3 Stainless steel 5 Fiberglass 8 RMP (SR) 10 Asbestos-cement 2 Brass 4 Galvanized steel 6 Concrete tile 9 ABS 12 None used (open hole) SCREEN OR PERFORATION OPENINGS ARE: 1 Continuous slot 3 Mill slot 5 Gauzed wrapped 8 Saw cut 11 None (open hole) 2 Louvered shutter 4 Key punched 6 Wire wrapped 9 Drilled holes 7 Torch cut 10 Other (specify) SCREEN-PERFORATED INTERVALS: From 50 ft. to 47.5 ft. From ft. to ft. GRAVEL PACK INTERVALS: From 50 ft. to 45 ft. From ft. to ft.

6 GROUT MATERIAL: 1 Neat cement 2 Cement grout 3 Bentonite 4 Other Grout Intervals: From 45 ft. to 3 ft. From ft. to ft. What is the nearest source of possible contamination: 1 Septic tank 4 Lateral lines 7 Pit privy 10 Livestock pens 14 Abandoned water well 2 Sewer lines 5 Cess pool 8 Sewage lagoon 11 Fuel storage 15 Oil well/Gas well 3 Watertight sewer lines 6 Seepage pit 9 Feedyard 12 Fertilizer storage 16 Other (specify below) 13 Insecticide storage Direction from well? How many feet?

FROM	TO	LITHOLOGIC LOG	FROM	TO	PLUGGING INTERVALS
0	5	Brn Clay			
5	50	Gray Sand			

7 CONTRACTOR'S OR LANDOWNER'S CERTIFICATION: This water well was 1) constructed, (2) reconstructed, or (3) plugged under my jurisdiction and was completed on (mo/day/year) 5-9-97 and this record is true to the best of my knowledge and belief. Kansas Water Well Contractor's License No. 568 This Water Well Record was completed on (mo/day/yr) 5-9-97 under the business name of Mark's by (signature) David H. Houghton

OFFICE USE ONLY

T

R

EW

SEC.

1/4

1/4

1/4