WATER WELL RECORD Form WWC-5 KSA 82a-1212

1 LOCATION OF WATER WELL: County: WYANDOTTE	Fraction: NW ¼ SW ¼ SW ¼	Section Number: 27	Township Number: T 10 S	Range Number: R 25 (E) W

Distance and direction from nearest town or city street address of well if located within city? See enclosed MAP

2 WATER WELL OWNER: UNISON TRANSFORMER SERVICES
RR#, St. Address, Box # : 3126 BRINKERHOFF Rd.
City, State, ZIP Code : KANSAS CITY, KS 66620

Board of Agriculture, Division of Water Resources Application Number: N/A

3 LOCATE WELL'S LOCATION WITH AN "X" IN SECTION BOX:

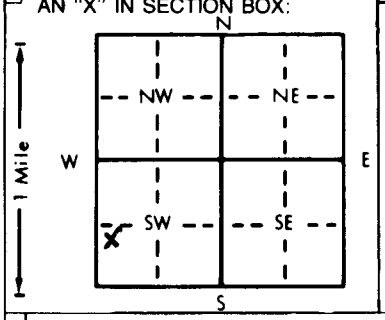

4 DEPTH OF COMPLETED WELL 68.0 ft. ELEVATION: N/A
Depth(s) Groundwater Encountered 1. 14.0 ft. 2. — ft. 3. — ft.
WELL'S STATIC WATER LEVEL 19.65 ft. below land surface measured on mo/day/yr 9/16/97
Pump test data: Well water was — ft. after — hours pumping — gpm
Est. Yield — gpm: Well water was — ft. after — hours pumping — gpm
Bore Hole Diameter 10 in. to 68.0 ft., and — in. to — ft.
WELL WATER TO BE USED AS: 1 Domestic 2 Irrigation 3 Feedlot 4 Industrial 5 Public water supply 6 Oil field water supply 7 Lawn and garden only 8 Air conditioning 9 Dewatering (10) Monitoring well 11 Injection well (12) Other (Specify below) PZ-1D
Was a chemical/bacteriological sample submitted to Department? Yes ..... No X ; If yes, mo/day/yr sample was submitted —
Water Well Disinfected? Yes No X

5 TYPE OF BLANK CASING USED: 1 Steel 3 RMP (SR) (2) PVC 4 ABS 5 Wrought iron 6 Asbestos-Cement 7 Fiberglass 8 Concrete tile 9 Other (specify below)
CASING JOINTS: Glued Clamped Welded Threaded X
Blank casing diameter 1 in. to 63.0 ft., Dia 2 in. to 3.0 ft., Dia — in. to — ft.
Casing height above land surface Ø in., weight — lbs./ft. Wall thickness or gauge No. Sch. 40
TYPE OF SCREEN OR PERFORATION MATERIAL: 1 Steel 2 Brass 3 Stainless steel 4 Galvanized steel 5 Fiberglass 6 Concrete tile (7) PVC 8 RMP (SR) 9 ABS 10 Asbestos-cement 11 Other (specify) 12 None used (open hole)
SCREEN OR PERFORATION OPENINGS ARE: 1 Continuous slot 2 Louvered shutter (3) Mill slot 4 Key punched 5 Gauzed wrapped 6 Wire wrapped 7 Torch cut 8 Saw cut 9 Drilled holes 10 Other (specify) 11 None (open hole)
SCREEN-PERFORATED INTERVALS: From 68.0 ft. to 63.0 ft., From — ft. to — ft.
From — ft. to — ft., From — ft. to — ft.
GRAVEL PACK INTERVALS: From 68.0 ft. to 61.0 ft., From — ft. to — ft.
From — ft. to — ft., From — ft. to — ft.

6 GROUT MATERIAL: 1 Neat cement (2) Cement grout (3) Bentonite 4 Other
Grout Intervals: From 61.0 ft. to 2.0 ft., From — ft. to — ft., From — ft. to — ft.
What is the nearest source of possible contamination: 1 Septic tank 2 Sewer lines 3 Watertight sewer lines 4 Lateral lines 5 Cess pool 6 Seepage pit 7 Pit privy 8 Sewage lagoon 9 Feedyard 10 Livestock pens 11 Fuel storage 12 Fertilizer storage 13 Insecticide storage 14 Abandoned water well 15 Oil well/Gas well (16) Other (specify below) OWNER FACILITY
Direction from well? West How many feet? <10

FROM	TO	LITHOLOGIC LOG	FROM	TO	PLUGGING INTERVALS
		GRANTED WAIVER "FLUSH"/DON TAYLOR			
Ø	8.0	Brown silty Clay, Damp, Firm			
8.0	11.0	Grey Brown Silty Clay, Firm			
11.0	25.0	Greyish Brown Med. Grain, Sand			
25.0	37.0	Grey Coarse Grain Sand, Wet			
37.0	39.0	Grey Clay Seam.			
39.0	58.0	Grey Brown Med-Coarse Sand			
58.0	59.5	Grey Dense Clay, Firm-Stiff			
59.5	68.0	Grey Brown Very Coarse Sand & Gravel.			

7 CONTRACTOR'S OR LANDOWNER'S CERTIFICATION: This water well was (1) constructed, (2) reconstructed, or (3) plugged under my jurisdiction and was completed on (mo/day/year) Sept. 16, 1997 and this record is true to the best of my knowledge and belief. Kansas Water Well Contractor's License No. 602 This Water Well Record was completed on (mo/day/yr) Oct. 6, 1997 under the business name of Hydro-Logic, Inc by (signature) [signature] VP.

INSTRUCTIONS: Use typewriter or ball point pen. *PLEASE PRESS FIRMLY* and *PRINT* clearly. Please fill in blanks, underline or circle the correct answers. Send top three copies to Kansas Department of Health and Environment, Bureau of Water, Topeka, Kansas 66620-0001. Telephone: 913-296-5545. Send one to WATER WELL OWNER and retain one for your records.

OFFICE USE ONLY T R E/W SEC. ¼ ¼ ¼