


1 LOCATION OF WATER WELL: Fraction SE 1/4 SW 1/4 SW 1/4 Section Number 27 Township Number T 10 S Range Number R 25 EW
 County: WYANDOTTE

Distance and direction from nearest town or city street address of well if located within city?

SEE ENCLOSED MAP

2 WATER WELL OWNER: UNISON TRANSFORMER SERVICES
 RR#, St. Address, Box #: 3126 BEINKORHOFF Rd. Board of Agriculture, Division of Water Resources
 City, State, ZIP Code: KASAS CITY, KS 66620 Application Number: N/A

3 LOCATE WELL'S LOCATION WITH AN "X" IN SECTION BOX:

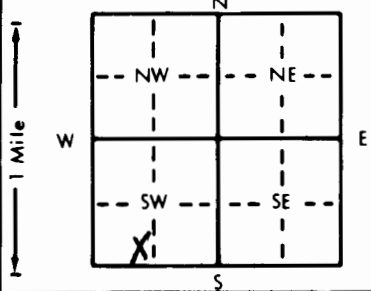

4 DEPTH OF COMPLETED WELL: 67.0 ft. ELEVATION: N/A
 Depth(s) Groundwater Encountered 1. 10.5 ft. 2. _____ ft. 3. _____ ft.
 WELL'S STATIC WATER LEVEL 15.16 ft. below land surface measured on mo/day/yr 9/16/97
 Pump test data: Well water was _____ ft. after _____ hours pumping _____ gpm
 Est. Yield _____ gpm Well water was _____ ft. after _____ hours pumping _____ gpm
 Bore Hole Diameter 6.5 in. to 15.0 ft., and 30" in. to 67.0 ft.
 WELL WATER TO BE USED AS:
 5 Public water supply 8 Air conditioning 11 Injection well
 1 Domestic 3 Feedlot 6 Oil field water supply 9 Dewatering 12 Other (Specify below)
 2 Irrigation 4 Industrial 7 Lawn and garden only 0 Monitoring well P2-25
 Was a chemical/bacteriological sample submitted to Department? Yes _____ No X; If yes, mo/day/yr sample was submitted _____
 Water Well Disinfected? Yes _____ No X

5 TYPE OF BLANK CASING USED:
 1 Steel 3 RMP (SR) 5 Wrought iron 8 Concrete tile CASING JOINTS: Glued _____ Clamped _____
 2 PVC 4 ABS 6 Asbestos-Cement 9 Other (specify below) Welded _____
 7 Fiberglass Threaded X
 Blank casing diameter 1 in. to 62.0 ft., Dia 2 in. to 3.0' ft., Dia _____ in. to _____ ft.
 Casing height above land surface 0 in., weight _____ lbs./ft. Wall thickness or gauge No. SCH. 40
 TYPE OF SCREEN OR PERFORATION MATERIAL:
 1 Steel 3 Stainless steel 5 Fiberglass 8 RMP (SR) 10 Asbestos-cement 11 Other (specify) _____
 2 Brass 4 Galvanized steel 6 Concrete tile 9 ABS 12 None used (open hole)
 SCREEN OR PERFORATION OPENINGS ARE:
 1 Continuous slot 3 Mill slot 5 Gauzed wrapped 8 Saw cut 11 None (open hole)
 2 Louvered shutter 4 Key punched 6 Wire wrapped 9 Drilled holes
 7 Torch cut 10 Other (specify) _____
 SCREEN-PERFORATED INTERVALS: From 62.0 ft. to 67.0 ft., From _____ ft. to _____ ft.
 From _____ ft. to _____ ft., From _____ ft. to _____ ft.
 GRAVEL PACK INTERVALS: From 60.0 ft. to 67.0 ft., From _____ ft. to _____ ft.
 From 6 ft. to _____ ft., From _____ ft. to _____ ft.

6 GROUT MATERIAL: 1 Neat cement 2 Cement grout 3 Bentonite 4 Other _____
 Grout Intervals: From 2.0 ft. to 60.0 ft., From _____ ft. to _____ ft., From _____ ft. to _____ ft.
 What is the nearest source of possible contamination:
 1 Septic tank 4 Lateral lines 7 Pit privy 10 Livestock pens 14 Abandoned water well
 2 Sewer lines 5 Cess pool 8 Sewage lagoon 11 Fuel storage 15 Oil well/Gas well
 3 Watertight sewer lines 6 Seepage pit 9 Feedyard 12 Fertilizer storage 16 Other (specify below) OWNER FACILITY
 13 Insecticide storage
 Direction from well? NW How many feet? ± 300.0

FROM	TO	LITHOLOGIC LOG	FROM	TO	PLUGGING INTERVALS
0	8.0	<u>GRAVEL WAIVER "FLUSH" / DON TAYLOR</u>			
8.0	14.0	<u>Brown Silty Clay, Damp, Firm</u>			
14.0	25.0	<u>Grey Brown Silty Clay, Firm</u>			
25.0	39.0	<u>Greyish Brown Med. Grain Sand, Wet</u>			
39.0	42.0	<u>Grey clay seam</u>			
42.0	59.5	<u>Grey Brown Coarse Sand</u>			
59.5	67.0	<u>Grey Brown Very Coars Sand & Gravel</u>			

7 CONTRACTOR'S OR LANDOWNER'S CERTIFICATION: This water well was (1) constructed, (2) reconstructed, or (3) plugged under my jurisdiction and was completed on (mo/day/year) Sept. 16, 1997 and this record is true to the best of my knowledge and belief. Kansas Water Well Contractor's License No. 602 This Water Well Record was completed on (mo/day/yr) Oct. 6, 1997 under the business name of Hydro-Logic, Inc. by (signature) [Signature]