

1 LOCATION OF WATER WELL: Fraction SE 1/4 SW 1/4 SW 1/4 Section Number 27 Township Number T 10 S Range Number R 25 (B)W
 County: WYANDOTTE


Distance and direction from nearest town or city street address of well if located within city?

See enclosed Map

2 WATER WELL OWNER: UNISON TRANSFORMATION SERVICES
 RR#, St. Address, Box #: 3126 BRINKHORST RD. Board of Agriculture, Division of Water Resources
 City, State, ZIP Code: KANSAS CITY, KS 661620 Application Number: N/A

3 LOCATE WELL'S LOCATION WITH AN "X" IN SECTION BOX:

4 DEPTH OF COMPLETED WELL: ~~15.0~~ 35.0 ft. ELEVATION: N/A
 Depth(s) Groundwater Encountered 1. 18.5 ft. 2. — ft. 3. — ft.
 WELL'S STATIC WATER LEVEL 15.98 ft. below land surface measured on mo/day/yr 9/16/97
 Pump test data: Well water was — ft. after — hours pumping — gpm
 Est. Yield — gpm: Well water was — ft. after — hours pumping — gpm
 Bore Hole Diameter 6.5 in. to 15.0 ft., and 3.0 in. to 35.0 ft.
 WELL WATER TO BE USED AS: 5 Public water supply 8 Air conditioning 11 Injection well
 1 Domestic 3 Feedlot 6 Oil field water supply 9 Dewatering 12 Other (Specify below)
 2 Irrigation 4 Industrial 7 Lawn and garden only 10 Monitoring well PZ-2D
 Was a chemical/bacteriological sample submitted to Department? Yes — No X; If yes, mo/day/yr sample was submitted —
 Water Well Disinfected? Yes — No X

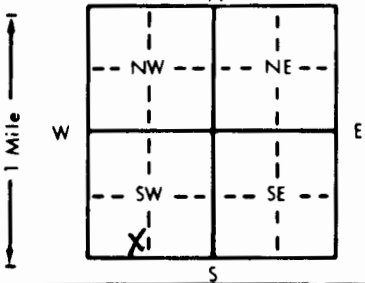

5 TYPE OF BLANK CASING USED: 1 Steel 3 RMP (SR) 5 Wrought iron 8 Concrete tile CASING JOINTS: Glued — Clamped —
 2 PVC 4 ABS 6 Asbestos-Cement 9 Other (specify below) Welded —
 7 Fiberglass Threaded X

Blank casing diameter 1 in. to 30.0 ft., Dia. 2 in. to 3.0' ft., Dia. — in. to — ft.
 Casing height above land surface — in., weight — lbs./ft. Wall thickness or gauge No. SCH. 40

TYPE OF SCREEN OR PERFORATION MATERIAL: 1 Steel 3 Stainless steel 5 Fiberglass 8 RMP (SR) 10 Asbestos-cement
 2 Brass 4 Galvanized steel 6 Concrete tile 9 ABS 11 Other (specify) —
 12 None used (open hole)

SCREEN OR PERFORATION OPENINGS ARE: 1 Continuous slot 3 Mill slot 5 Gauzed wrapped 8 Saw cut 11 None (open hole)
 2 Louvered shutter 4 Key punched 6 Wire wrapped 9 Drilled holes
 7 Torch cut 10 Other (specify) —

SCREEN-PERFORATED INTERVALS: From 30.0 ft. to 35.0 ft., From — ft. to — ft.
 From — ft. to — ft., From — ft. to — ft.
 GRAVEL PACK INTERVALS: From 28.0 ft. to 35.0 ft., From — ft. to — ft.
 From — ft. to — ft., From — ft. to — ft.

6 GROUT MATERIAL: 1 Neat cement 2 Cement grout 3 Bentonite 4 Other
 Grout Intervals: From 2.0 ft. to 28.0 ft., From — ft. to — ft., From — ft. to — ft.

What is the nearest source of possible contamination: 1 Septic tank 4 Lateral lines 7 Pit privy 10 Livestock pens 14 Abandoned water well
 2 Sewer lines 5 Cess pool 8 Sewage lagoon 11 Fuel storage 15 Oil well/Gas well
 3 Watertight sewer lines 6 Seepage pit 9 Feedyard 12 Fertilizer storage 16 Other (specify below) OWNER FACILITY
 13 Insecticide storage
 Direction from well? NW How many feet? 300.0

FROM	TO	LITHOLOGIC LOG	FROM	TO	PLUGGING INTERVALS
0	8.0	GRAVEL UNDER "FLUSH" / DON TALKER			
8.0	14.0	Brown Silty clay, Firm, damp			
14.0	25.0	Grey Brown Silty clay, Firm			
25.0	35.0	Grey Brown med. Sand, Wet			
		Greyish Brown Med. to Coarse Sand			

7 CONTRACTOR'S OR LANDOWNER'S CERTIFICATION: This water well was (1) constructed, (2) reconstructed, or (3) plugged under my jurisdiction and was completed on (mo/day/year) Sept. 16, 1997 and this record is true to the best of my knowledge and belief. Kansas Water Well Contractor's License No. 602 This Water Well Record was completed on (mo/day/yr) Oct 6, 1997 under the business name of Hydro-LOGIC, INC. by (signature) [Signature] NP

OFFICE USE ONLY

T

R

EW

SEC.

1/4

1/4