


1 LOCATION OF WATER WELL: County: Wyandotte Fraction: NE 1/4 SW 1/4 SW 1/4 Section Number: 27 Township Number: T 10 S Range Number: R 25 E/W

Distance and direction from nearest town or city street address of well if located within city?  
See Enclosed Map

2 WATER WELL OWNER: Unison Transformer Services  
RR#, St. Address, Box #: 3126 Brinkerhoff Road Board of Agriculture, Division of Water Resources  
City, State, ZIP Code: Kansas City, KS 66620 Application Number: N/A

3 LOCATE WELL'S LOCATION WITH AN "X" IN SECTION BOX:

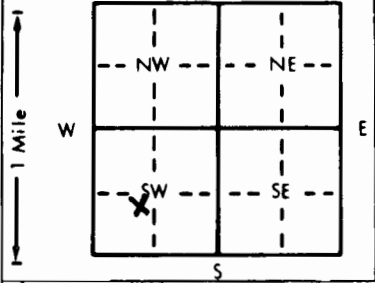

4 DEPTH OF COMPLETED WELL: 35.0 ft. ELEVATION: N/A  
Depth(s) Groundwater Encountered 1. 14.0 ft. 2. — ft. 3. — ft.  
WELL'S STATIC WATER LEVEL: 14.04 ft. below land surface measured on mo/day/yr 9/16/97  
Pump test data: Well water was — ft. after — hours pumping — gpm  
Est. Yield — gpm: Well water was — ft. after — hours pumping — gpm  
Bore Hole Diameter: 6.5' in. to 15.0' ft., and 3.0 in. to 35.0 ft.  
WELL WATER TO BE USED AS:  
5 Public water supply 8 Air conditioning 11 Injection well  
1 Domestic 3 Feedlot 6 Oil field water supply 9 Dewatering 12 Other (Specify below)  
2 Irrigation 4 Industrial 7 Lawn and garden only 10 Monitoring well PZ-35  
Was a chemical/bacteriological sample submitted to Department? Yes — No X; If yes, mo/day/yr sample was submitted —  
Water Well Disinfected? Yes — No X

5 TYPE OF BLANK CASING USED:  
1 Steel 3 RMP (SR) 5 Wrought iron 8 Concrete tile CASING JOINTS: Glued — Clamped —  
3 PVC 4 ABS 6 Asbestos-Cement 9 Other (specify below) Welded —  
Blank casing diameter 1 in. to 28.0 ft. Dia 2 in. to 3.0 ft. Dia — in. to — ft.  
Casing height above land surface 0 in. weight — lbs./ft. Wall thickness or gauge No. SCH. 40  
TYPE OF SCREEN OR PERFORATION MATERIAL:  
1 Steel 3 Stainless steel 5 Fiberglass 8 RMP (SR) 10 Asbestos-cement  
2 Brass 4 Galvanized steel 6 Concrete tile 9 ABS 11 Other (specify) 7 PVC 12 None used (open hole)  
SCREEN OR PERFORATION OPENINGS ARE:  
1 Continuous slot 3 Mill slot 5 Gauzed wrapped 8 Saw cut 11 None (open hole)  
2 Louvered shutter 4 Key punched 6 Wire wrapped 9 Drilled holes  
3 Torch cut 10 Other (specify) —  
SCREEN-PERFORATED INTERVALS: From 30.0 ft. to 35.0 ft., From — ft. to — ft.  
From — ft. to — ft., From — ft. to — ft.  
GRAVEL PACK INTERVALS: From 28.0 ft. to 35.0 ft., From — ft. to — ft.  
From — ft. to — ft., From — ft. to — ft.

6 GROUT MATERIAL: 1 Neat cement 2 Cement grout 3 Bentonite 4 Other —  
Grout Intervals: From 2.0 ft. to 28.0 ft., From — ft. to — ft., From — ft. to — ft.  
What is the nearest source of possible contamination:  
1 Septic tank 4 Lateral lines 7 Pit privy 10 Livestock pens 14 Abandoned water well  
2 Sewer lines 5 Cess pool 8 Sewage lagoon 11 Fuel storage 15 Oil well/Gas well  
3 Watertight sewer lines 6 Seepage pit 9 Feedyard 12 Fertilizer storage 16 Other (specify below) OWNER FACILITY  
13 Insecticide storage  
Direction from well? West How many feet? ≈ 200

FROM	TO	LITHOLOGIC LOG	FROM	TO	PLUGGING INTERVALS
		<u>GRANTED FLUSH WAIVER / DON TAYLOR</u>			
<u>0</u>	<u>10.0</u>	<u>Brown Silty clay, Firm, Dry</u>			
<u>10.0</u>	<u>22.0</u>	<u>Gray Brown Silty Clay to Med Sand, Wet</u>			
<u>22.0</u>	<u>31.0</u>	<u>Coarse Grain Sand, Wet</u>			
<u>31.0</u>	<u>35.0</u>	<u>Greyish Brown Silty Clay Sand</u>			

7 CONTRACTOR'S OR LANDOWNER'S CERTIFICATION: This water well was (1) constructed, (2) reconstructed, or (3) plugged under my jurisdiction and was completed on (mo/day/year) Sept. 16, 1997 and this record is true to the best of my knowledge and belief. Kansas Water Well Contractor's License No. 602 This Water Well Record was completed on (mo/day/yr) Oct. 9, 1997 under the business name of Hydro-LOGIC, Inc. by (signature) [Signature]

OFFICE USE ONLY  
T  
R  
E/W  
SEC.  
1/4  
1/4  
1/4