


1 LOCATION OF WATER WELL: Fraction NE 1/4 SW 1/4 SW 1/4 Section Number 27 Township Number T 10 S Range Number R 25 E/W
 County: WYANDOTTE

Distance and direction from nearest town or city street address of well if located within city?
See enclosed Map

2 WATER WELL OWNER: UNISON TRANSFORMER SERVICES
 RR#, St. Address, Box #: 3126 BRINKERHOFF Rd. Board of Agriculture, Division of Water Resources
 City, State, ZIP Code: KANSAS CITY, KS 66620 Application Number: N/A

3 LOCATE WELL'S LOCATION WITH AN "X" IN SECTION BOX: 4 DEPTH OF COMPLETED WELL: 68.0 ft. ELEVATION: N/A
 Depth(s) Groundwater Encountered 1. 14.0 ft. 2. — ft. 3. — ft.
 WELL'S STATIC WATER LEVEL: 13.97 ft. below land surface measured on mo/day/yr 9/16/77
 Pump test data: Well water was — ft. after — hours pumping — gpm
 Est. Yield — gpm: Well water was — ft. after — hours pumping — gpm
 Bore Hole Diameter: 6.5 in. to 15.0' ft., and 3.0" in. to 68.0 ft.
 WELL WATER TO BE USED AS:
 1 Domestic 3 Feedlot 6 Oil field water supply 9 Dewatering 12 Other (Specify below)
 2 Irrigation 4 Industrial 7 Lawn and garden only Monitoring well PZ-3D

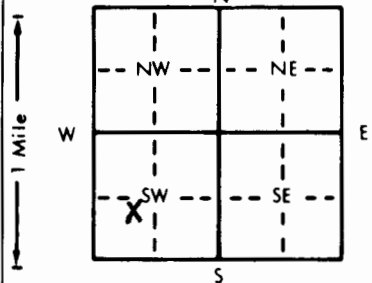

Was a chemical/bacteriological sample submitted to Department? Yes — No — If yes, mo/day/yr sample was submitted —
 Water Well Disinfected? Yes — No X

5 TYPE OF BLANK CASING USED:
 1 Steel 3 RMP (SR) 5 Wrought iron 8 Concrete tile CASING JOINTS: Glued — Clamped —
 PVC 4 ABS 6 Asbestos-Cement 9 Other (specify below) Welded —
 7 Fiberglass Threaded X
 Blank casing diameter 1" in. to 63.0 ft., Dia 2' in. to 3.0 ft., Dia — in. to — ft.
 Casing height above land surface 0 in., weight — lbs./ft. Wall thickness or gauge No. SCH. 40

TYPE OF SCREEN OR PERFORATION MATERIAL:
 1 Steel 3 Stainless steel 5 Fiberglass 8 RMP (SR) 10 Asbestos-cement
 2 Brass 4 Galvanized steel 6 Concrete tile 9 ABS 11 Other (specify) —
 12 None used (open hole)

SCREEN OR PERFORATION OPENINGS ARE:
 1 Continuous slot Mill slot 5 Gauzed wrapped 8 Saw cut 11 None (open hole)
 2 Louvered shutter 4 Key punched 6 Wire wrapped 9 Drilled holes
 7 Torch cut 10 Other (specify) —

SCREEN-PERFORATED INTERVALS: From 63.0 ft. to 68.0 ft., From — ft. to — ft.
 From — ft. to — ft., From — ft. to — ft.
 GRAVEL PACK INTERVALS: From 61.0 ft. to 68.0 ft., From — ft. to — ft.
 From — ft. to — ft., From — ft. to — ft.

6 GROUT MATERIAL: 1 Neat cement Cement grout Bentonite 4 Other —
 Grout Intervals: From 2.0 ft. to 61.0 ft., From — ft. to — ft., From — ft. to — ft.
 What is the nearest source of possible contamination:
 1 Septic tank 4 Lateral lines 7 Pit privy 10 Livestock pens 14 Abandoned water well
 2 Sewer lines 5 Cess pool 8 Sewage lagoon 11 Fuel storage 15 Oil well/Gas well
 3 Watertight sewer lines 6 Seepage pit 9 Feedyard 12 Fertilizer storage Other (specify below) OWNER FACILITY
 13 Insecticide storage
 Direction from well? West How many feet? 200

FROM	TO	LITHOLOGIC LOG	FROM	TO	PLUGGING INTERVALS
<u>0</u>	<u>10.0</u>	<u>GRANTED WAIVER "FRESH" / DON'T TAKE</u>			
<u>10.0</u>	<u>22.0</u>	<u>Brown Silty Clay, Firm, Dry</u>			
<u>22.0</u>	<u>31.0</u>	<u>Greenish Brown Silty Clay to Med Sand, wet</u>			
<u>31.0</u>	<u>36.0</u>	<u>Grey Coarse Cornin Sand, wet</u>			
<u>36.0</u>	<u>57.0</u>	<u>Greyish Brown Silty Clay seam</u>			
<u>57.0</u>	<u>68.0</u>	<u>Grey Sand with dense clay seams</u>			
		<u>Grey Brown Very Coarse Sand & Gravel</u>			

7 CONTRACTOR'S OR LANDOWNER'S CERTIFICATION: This water well was constructed, reconstructed, or plugged under my jurisdiction and was completed on (mo/day/year) Sept. 16/1997 and this record is true to the best of my knowledge and belief. Kansas Water Well Contractor's License No. 602 This Water Well Record was completed on (mo/day/yr) Oct 6, 1997 under the business name of Hydro-Logix, Inc. by (signature) [Signature] /OP

OFFICE USE ONLY