


1 LOCATION OF WATER WELL: Fraction SW 1/4 SW 1/4 SW 1/4 Section Number 27 Township Number T 10 S Range Number R 25 EW
 County: WYANDOTTE

Distance and direction from nearest town or city street address of well if located within city?
3126 BRINKERHOFF KANSAS CITY KS

2 WATER WELL OWNER: UNISON IW-1
 RR#, St. Address, Box #: 3126 BRINKERHOFF Board of Agriculture, Division of Water Resources
 City, State, ZIP Code: KANSAS CITY KS 66115 Application Number:

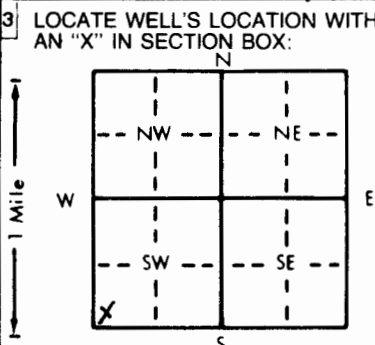

4 DEPTH OF COMPLETED WELL: 33.5 ft. ELEVATION:
 Depth(s) Groundwater Encountered 1. 19.0 ft. 2. ft. 3. ft.
 WELL'S STATIC WATER LEVEL 19.0 ft. below land surface measured on mo/day/yr 7-7-97
 Pump test data: Well water was ft. after hours pumping gpm
 Est. Yield gpm: Well water was ft. after hours pumping gpm
 Bore Hole Diameter 12 in. to 20 ft., and 6 in. to 33.5 ft.
 WELL WATER TO BE USED AS: 5 Public water supply 8 Air conditioning 11 Injection well
 1 Domestic 3 Feedlot 6 Oil field water supply 9 Dewatering 12 Other (Specify below)
 2 Irrigation 4 Industrial 7 Lawn and garden only 10 Monitoring well
 Was a chemical/bacteriological sample submitted to Department? Yes No ; If yes, mo/day/yr sample was submitted
 Water Well Disinfected? Yes No

5 TYPE OF BLANK CASING USED: 5 Wrought iron 8 Concrete tile CASING JOINTS: Glued Clamped
 Steel 3 RMP (SR) 6 Asbestos-Cement 9 Other (specify below) Welded
 PVC ABS 7 Fiberglass Threaded
 Blank casing diameter 6 in. to 20 ft., Dia 1.5 in. to 28 ft., Dia in. to ft.
 Casing height above land surface in., weight lbs./ft. Wall thickness or gauge No. SCHED 40

TYPE OF SCREEN OR PERFORATION MATERIAL: PVC 10 Asbestos-cement
 1 Steel 3 Stainless steel 5 Fiberglass 8 RMP (SR) 11 Other (specify)
 2 Brass 4 Galvanized steel 6 Concrete tile 9 ABS 12 None used (open hole)

SCREEN OR PERFORATION OPENINGS ARE: 5 Gauzed wrapped 8 Saw cut 11 None (open hole)
 1 Continuous slot Mill slot 0.010" 6 Wire wrapped 9 Drilled holes
 2 Louvered shutter 4 Key punched 7 Torch cut 10 Other (specify)

SCREEN-PERFORATED INTERVALS: From 28.0 ft. to 33.5 ft., From ft. to ft.
 From ft. to ft., From ft. to ft.
 GRAVEL PACK INTERVALS: From 21 ft. to 33.5 ft., From ft. to ft.
 From ft. to ft., From ft. to ft.

6 GROUT MATERIAL: 1 Neat cement 2 Cement grout Bentonite Other CONCRETE
 Grout Intervals From 0.0 ft. to 1.0 ft. From 1.0 ft. to 21.0 ft., From ft. to ft.
 What is the nearest source of possible contamination:
 1 Septic tank 4 Lateral lines 7 Pit privy 10 Livestock pens 14 Abandoned water well
 2 Sewer lines 5 Cess pool 8 Sewage lagoon 11 Fuel storage 15 Oil well/Gas well
 3 Watertight sewer lines 6 Seepage pit 9 Feedyard 12 Fertilizer storage Other (specify below) INDUSTRIAL SITE
 13 Insecticide storage

Direction from well? How many feet?

FROM	TO	LITHOLOGIC LOG	FROM	TO	PLUGGING INTERVALS
0.0	5.5	BROWN CLAY (FIL)			
5.5	7.0	DK GRAY SILT			
7.0	9.0	GRAY CLAYEY SILT			
9.0	17.0	GRAY SILTY CLAY			
17.0	19.5	GRAY CLAYEY SILT			
19.5	33.5	BROWN FINE SAND			

7 CONTRACTOR'S OR LANDOWNER'S CERTIFICATION: This water well was constructed, (2) reconstructed, or (3) plugged under my jurisdiction and was completed on (mo/day/year) 7-7-97 and this record is true to the best of my knowledge and belief. Kansas Water Well Contractor's License No. 416 This Water Well Record was completed on (mo/day/yr) 9-23-97 under the business name of TERRACON CONSULTANTS INC by (signature) Clay P. Oyer