


1 LOCATION OF WATER WELL: Fraction SW 1/4 SW 1/4 SW 1/4 Section Number 27 Township Number T 10 S Range Number R 25 W
 County: WYANDOTTE

Distance and direction from nearest town or city street address of well if located within city?
3126 BRINKERHOFF KANSAS CITY KS

2 WATER WELL OWNER: UNISON MW-E
 RR#, St. Address, Box #: 3126 BRINKERHOFF Board of Agriculture, Division of Water Resources
 City, State, ZIP Code: KANSAS CITY KS 66215 Application Number:

3 LOCATE WELL'S LOCATION WITH AN "X" IN SECTION BOX:

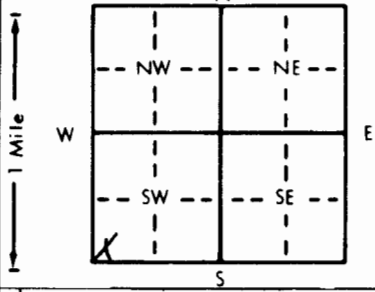

4 DEPTH OF COMPLETED WELL: 35.5 ft. ELEVATION:
 Depth(s) Groundwater Encountered 1. 19.0 ft. 2. ft. 3. ft.
 WELL'S STATIC WATER LEVEL: 19.0 ft. below land surface measured on mo/day/yr 3-19-97
 Pump test data: Well water was ft. after hours pumping gpm
 Est. Yield gpm: Well water was ft. after hours pumping gpm
 Bore Hole Diameter: 8.25 in. to 43.0 ft., and in. to ft.

WELL WATER TO BE USED AS:
 5 Public water supply 8 Air conditioning 11 Injection well
 1 Domestic 3 Feedlot 6 Oil field water supply 9 Dewatering 12 Other (Specify below)
 2 Irrigation 4 Industrial 7 Lawn and garden only 10 Monitoring well
 Was a chemical/bacteriological sample submitted to Department? Yes No ; If yes, mo/day/yr sample was submitted
 Water Well Disinfected? Yes No

5 TYPE OF BLANK CASING USED:
 1 Steel 3 RMP (SR) 5 Wrought iron 8 Concrete tile CASING JOINTS: Glued Clamped
 2 PVC 4 ABS 6 Asbestos-Cement 9 Other (specify below) Welded
 7 Fiberglass Threaded

Blank casing diameter: 2 in. to 29.9 ft., Dia. in. to ft., Dia. in. to ft.
 Casing height above land surface: in., weight lbs./ft. Wall thickness or gauge No. SCHED 40

TYPE OF SCREEN OR PERFORATION MATERIAL:
 1 Steel 3 Stainless steel 5 Fiberglass 8 RMP (SR) 10 Asbestos-cement
 2 Brass 4 Galvanized steel 6 Concrete tile 9 ABS 11 Other (specify)
 12 None used (open hole)

SCREEN OR PERFORATION OPENINGS ARE:
 1 Continuous slot 3 Mill slot 0.010" 5 Gauzed wrapped 8 Saw cut 11 None (open hole)
 2 Louvered shutter 4 Key punched 6 Wire wrapped 9 Drilled holes
 7 Torch cut 10 Other (specify)

SCREEN-PERFORATED INTERVALS: From 29.9 ft. to 35.5 ft., From ft. to ft.
 From ft. to ft., From ft. to ft.
 GRAVEL PACK INTERVALS: From 28.0 ft. to 35.5 ft., From ft. to ft.
 From ft. to ft., From ft. to ft.

6 GROUT MATERIAL: 1 Neat cement 2 Cement grout 3 Bentonite 4 Other CONCRETE
 Grout Intervals: From 0.0 ft. to 0.6 ft., From 0.6 ft. to 26.0 ft., From 26.0 ft. to 28.0 ft.

What is the nearest source of possible contamination:
 1 Septic tank 4 Lateral lines 7 Pit privy 10 Livestock pens 14 Abandoned water well
 2 Sewer lines 5 Cess pool 8 Sewage lagoon 11 Fuel storage 15 Oil well/Gas well
 3 Watertight sewer lines 6 Seepage pit 9 Feedyard 12 Fertilizer storage 16 Other (specify below) INDUSTRIAL SITE
 13 Insecticide storage

Direction from well? How many feet?

FROM	TO	LITHOLOGIC LOG	FROM	TO	PLUGGING INTERVALS
0.0	6.0	BROWN CLAY (FILL)			
6.0	9.0	BROWN CLAYEY SILT			
9.0	11.0	GRAY SILTY CLAY			
11.0	19.0	BROWN-GRAY CLAYEY SILT			
19.0	43.0	GRAY FINE to MED SAND			

7 CONTRACTOR'S OR LANDOWNER'S CERTIFICATION: This water well was constructed, (2) reconstructed, or (3) plugged under my jurisdiction and was completed on (mo/day/year) 3-19-97 and this record is true to the best of my knowledge and belief. Kansas Water Well Contractor's License No. 416 This Water Well Record was completed on (mo/day/yr) 9-23-97 under the business name of TERRACON CONSULTANTS INC by (signature) Clay P. Nye