


1 LOCATION OF WATER WELL: County: **WYANDOTTE** Fraction: **SW 1/4 SW 1/4 SW 1/4** Section Number: **27** Township Number: **T 10 S** Range Number: **R 25 E**

Distance and direction from nearest town or city street address of well if located within city?
3126 BRINKERHOFF KANSAS CITY, KS

2 WATER WELL OWNER: **UNISON** MW AA
 RR#, St. Address, Box #: **3126 BRINKERHOFF**
 City, State, ZIP Code: **KANSAS CITY, KS 64615**
 Board of Agriculture, Division of Water Resources
 Application Number:

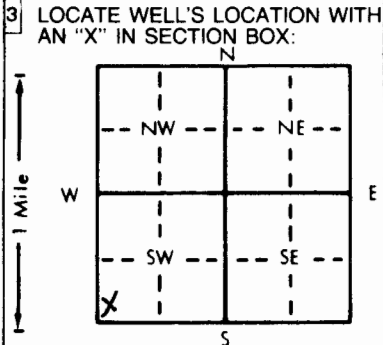

4 DEPTH OF COMPLETED WELL: **32.0** ft. ELEVATION:
 Depth(s) Groundwater Encountered 1. **20.0** ft. 2. ft. 3. ft.
 WELL'S STATIC WATER LEVEL **20.0** ft. below land surface measured on mo/day/yr **3-21-97**
 Pump test data: Well water was ft. after hours pumping gpm
 Est. Yield gpm: Well water was ft. after hours pumping gpm
 Bore Hole Diameter **8.25** in. to **34.0** ft., and in. to ft.
 WELL WATER TO BE USED AS:
 1 Domestic 3 Feedlot 6 Oil field water supply 9 Dewatering 12 Other (Specify below)
 2 Irrigation 4 Industrial 7 Lawn and garden only Monitoring well
 Was a chemical/bacteriological sample submitted to Department? Yes..... No.....; If yes, mo/day/yr sample was submitted
 Water Well Disinfected? Yes No

5 TYPE OF BLANK CASING USED:
 1 Steel 3 RMP (SR) 5 Wrought iron 8 Concrete tile CASING JOINTS: Glued Clamped
 PVC 4 ABS 7 Fiberglass Threaded.
 Blank casing diameter **2** in. to **26.5** ft., Dia in. to ft., Dia in. to ft.
 Casing height above land surface in., weight lbs./ft. Wall thickness or gauge No. **SCHED 40**

TYPE OF SCREEN OR PERFORATION MATERIAL:
 PVC 10 Asbestos-cement
 1 Steel 3 Stainless steel 5 Fiberglass 8 RMP (SR) 11 Other (specify)
 2 Brass 4 Galvanized steel 6 Concrete tile 9 ABS 12 None used (open hole)

SCREEN OR PERFORATION OPENINGS ARE:
 1 Continuous slot Mill slot **0.010"** 6 Wire wrapped 9 Drilled holes
 2 Louvered shutter 4 Key punched 7 Torch cut 10 Other (specify)

SCREEN-PERFORATED INTERVALS: From **26.5** ft. to **32.0** ft., From ft. to ft.
 From ft. to ft., From ft. to ft.
 GRAVEL PACK INTERVALS: From **22.0** ft. to **32.0** ft., From ft. to ft.
 From ft. to ft., From ft. to ft.

6 GROUT MATERIAL: 1 Neat cement 2 Cement grout 3 Bentonite 4 Other **CONCRETE**
 Grout Intervals: From **0.6** ft. to **12.2** ft., From **12.2** ft. to **22.0** ft., From **0** ft. to **0.6** ft.
 What is the nearest source of possible contamination:
 1 Septic tank 4 Lateral lines 7 Pit privy 10 Livestock pens 14 Abandoned water well
 2 Sewer lines 5 Cess pool 8 Sewage lagoon 11 Fuel storage 15 Oil well/Gas well
 3 Watertight sewer lines 6 Seepage pit 9 Feedyard 12 Fertilizer storage Other (specify below) **INDUSTRIAL SITE**
 Direction from well? How many feet?

FROM	TO	LITHOLOGIC LOG	FROM	TO	PLUGGING INTERVALS
0.0	5.0	BROWN CLAY (FILL)			
5.0	6.0	DK GRAY SILT			
6.0	10.0	GRAY CLAYEY SILT			
10.0	17.0	GRAY SILTY CLAY			
17.0	34.0	GRAY CLAYEY SILT / SAND			

7 CONTRACTOR'S OR LANDOWNER'S CERTIFICATION: This water well was constructed, (2) reconstructed, or (3) plugged under my jurisdiction and was completed on (mo/day/year) **3-23-97** and this record is true to the best of my knowledge and belief. Kansas Water Well Contractor's License No. **416** This Water Well Record was completed on (mo/day/yr) **9-22-97** under the business name of **TERRACON CONSULTANTS INC** by (signature) **Clay P. Nyer**

INSTRUCTIONS: Use typewriter or ball point pen. PLEASE PRESS FIRMLY and PRINT clearly. Please fill in blanks, underline or circle the correct answers. Send top three copies to Kansas Department of Health and Environment, Bureau of Water, Topeka, Kansas 66620-0001. Telephone: 913-296-5545. Send one to WATER WELL OWNER and retain one for your records.