


1 LOCATION OF WATER WELL: Fraction $\frac{1}{4}$ SW $\frac{1}{4}$ NE $\frac{1}{4}$ Section Number 34 Township Number T 10 S Range Number R 25 E/W

Distance and direction from nearest town or city street address of well if located within city?
 Sealright Facility NW corner of Fairfax + Donovan Rd, KCK

2 WATER WELL OWNER: Sealright
 RR#, St. Address, Box #: 2925 Fairfax
 City, State, ZIP Code: Kansas City, KS 66018
 Board of Agriculture, Division of Water Resources
 Application Number:

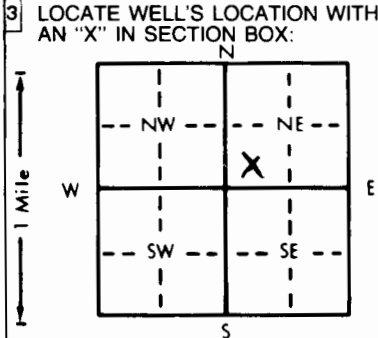

4 DEPTH OF COMPLETED WELL: 25 ft. ELEVATION: -
 Depth(s) Groundwater Encountered 1. 12 ft. 2. - ft. 3. - ft.
 WELL'S STATIC WATER LEVEL: - ft. below land surface measured on mo/day/yr
 Pump test data: Well water was - ft. after - hours pumping - gpm
 Est. Yield - gpm; Well water was - ft. after - hours pumping - gpm
 Bore Hole Diameter 11.5 in. to 25 ft. and - in. to - ft.
 WELL WATER TO BE USED AS:
 1 Domestic 2 Irrigation 3 Feedlot 4 Industrial 5 Public water supply 6 Oil field water supply 7 Lawn and garden only 8 Air conditioning 9 Dewatering 10 Monitoring well 11 Injection well 12 Other (Specify below)
 10 Monitoring well SVE-3
 Was a chemical/bacteriological sample submitted to Department? Yes - No X
 If yes, mo/day/yr sample was submitted -
 Water Well Disinfected? Yes - No X

5 TYPE OF BLANK CASING USED:
 1 Steel 2 PVC 3 RMP (SR) 4 ABS 5 Wrought iron 6 Asbestos-Cement 7 Fiberglass 8 Concrete tile 9 Other (specify below)
 Casing diameter 4 in. to 25 ft. Dia - in. to - ft. Dia - in. to - ft.
 Casing height above land surface 0 in., weight - lbs./ft. Wall thickness or gauge No. -
 TYPE OF SCREEN OR PERFORATION MATERIAL:
 1 Steel 2 Brass 3 Stainless steel 4 Galvanized steel 5 Fiberglass 6 Concrete tile 7 PVC 8 RMP (SR) 9 ABS 10 Asbestos-cement 11 Other (specify) 12 None used (open hole)
 SCREEN OR PERFORATION OPENINGS ARE:
 1 Continuous slot 2 Louvered shutter 3 Mill slot 4 Key punched 5 Gauzed wrapped 6 Wire wrapped 7 Torch cut 8 Saw cut 9 Drilled holes 10 Other (specify) 11 None (open hole)
 SCREEN-PERFORATED INTERVALS: From 5 ft. to 20 ft. From - ft. to - ft. From - ft. to - ft.
 GRAVEL PACK INTERVALS: From 4 ft. to 20 ft. From - ft. to - ft. From - ft. to - ft.

6 GROUT MATERIAL: 1 Neat cement 2 Cement grout 3 Bentonite 4 Other
 Grout Intervals: From 20 ft. to 2 ft. From 3 ft. to 2 ft. From 4 ft. to - ft.
 What is the nearest source of possible contamination:
 1 Septic tank 2 Sewer lines 3 Watertight sewer lines 4 Lateral lines 5 Cess pool 6 Seepage pit 7 Pit privy 8 Sewage lagoon 9 Feedyard 10 Livestock pens 11 Fuel storage 12 Fertilizer storage 13 Insecticide storage 14 Abandoned water well 15 Oil well/Gas well 16 Other (specify below)
 16 Other (specify below) Contaminated Site
 Direction from well? How many feet?

FROM	TO	LITHOLOGIC LOG	FROM	TO	PLUGGING INTERVALS
0	2.0	Fill			
2.0	7.0	clay, brown, plastic			
7.0	8.0	Sand (SW)			
8.0	9.0	Clay (CC)			
9.0	25.0	Sand (SW)			
25.0	TD	End of borehole			

7 CONTRACTOR'S OR LANDOWNER'S CERTIFICATION: This water well was (1) constructed, (2) reconstructed, or (3) plugged under my jurisdiction and was completed on (mo/day/year) 8-4-97 and this record is true to the best of my knowledge and belief. Kansas Water Well Contractor's License No. 585 This Water Well Record was completed on (mo/day/yr) 9-2-97 under the business name of AEI by (signature) [Signature]