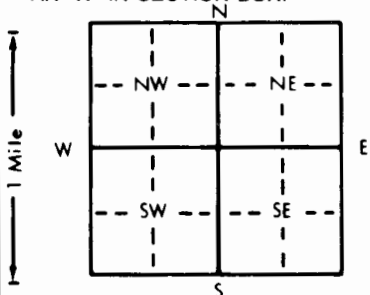


1 LOCATION OF WATER WELL: Fraction  $\frac{1}{4}$  SW  $\frac{1}{4}$  NE  $\frac{1}{4}$  Section Number 34 Township Number T 10 S Range Number R 25 EW  
 County: Wyandotte

Distance and direction from nearest town or city street address of well if located within city?  
 Sealright Facility - NW corner of Fairfax + Donovan Rd, KCK

2 WATER WELL OWNER: Sealright  
 RR#, St. Address, Box #: 2925 Fairfax Board of Agriculture, Division of Water Resources  
 City, State, ZIP Code: Kansas City, KS 66018 Application Number: -

3 LOCATE WELL'S LOCATION WITH AN "X" IN SECTION BOX:  
  
 4 DEPTH OF COMPLETED WELL: 25 ft. ELEVATION: -  
 Depth(s) Groundwater Encountered 1. 12 ft. 2. - ft. 3. - ft.  
 WELL'S STATIC WATER LEVEL: - ft. below land surface measured on mo/day/yr -  
 Pump test data: Well water was - ft. after - hours pumping - gpm  
 Est. Yield - gpm: Well water was - ft. after - hours pumping - gpm  
 Bore Hole Diameter: 8.5 in. to 25 ft., and - in. to - ft.  
 WELL WATER TO BE USED AS:  
 5 Public water supply 8 Air conditioning 11 Injection well  
 1 Domestic 3 Feedlot 6 Oil field water supply 9 Dewatering 12 Other (Specify below)  
 2 Irrigation 4 Industrial 7 Lawn and garden only 10 Monitoring well AS-1  
 Was a chemical/bacteriological sample submitted to Department? Yes - No X; If yes, mo/day/yr sample was submitted -  
 Water Well Disinfected? Yes - No X

5 TYPE OF BLANK CASING USED:  
 1 Steel 3 RMP (SR) 5 Wrought iron 8 Concrete tile CASING JOINTS: Glued - Clamped -  
 2 PVC 4 ABS 6 Asbestos-Cement 9 Other (specify below) Welded -  
 7 Fiberglass Threaded X  
 Blank casing diameter: 1 in. to 18 ft., Dia - in. to - ft., Dia - in. to - ft.  
 Casing height above land surface: 0 in., weight - lbs./ft. Wall thickness or gauge No. -  
 TYPE OF SCREEN OR PERFORATION MATERIAL:  
 1 Steel 3 Stainless steel 5 Fiberglass 8 RMP (SR) 10 Asbestos-cement  
 2 Brass 4 Galvanized steel 6 Concrete tile 9 ABS 11 Other (specify) -  
 12 None used (open hole)  
 SCREEN OR PERFORATION OPENINGS ARE:  
 1 Continuous slot 3 Mill slot 5 Gauzed wrapped 8 Saw cut 11 None (open hole)  
 2 Louvered shutter 4 Key punched 6 Wire wrapped 9 Drilled holes  
 7 Torch cut 10 Other (specify) -  
 SCREEN-PERFORATED INTERVALS: From - ft. to - ft., From - ft. to - ft.  
 GRAVEL PACK INTERVALS: From 14 ft. to 20 ft., From - ft. to - ft.

6 GROUT MATERIAL: 1 Neat cement 2 Cement grout 3 Bentonite 4 Other  
 Grout Intervals: From 2 GL ft. to 9.5 ft., From 9.5 ft. to 14 ft., From - ft. to - ft.  
 What is the nearest source of possible contamination:  
 1 Septic tank 4 Lateral lines 7 Pit privy 10 Livestock pens 14 Abandoned water well  
 2 Sewer lines 5 Cess pool 8 Sewage lagoon 11 Fuel storage 15 Oil well/Gas well  
 3 Watertight sewer lines 6 Seepage pit 9 Feedyard 12 Fertilizer storage 16 Other (specify below)  
 Cont. Site  
 Direction from well? How many feet?

FROM	TO	LITHOLOGIC LOG	FROM	TO	PLUGGING INTERVALS
0	2.0	Fill			
2.0	7.0	clay			
7.0	8.0	sand (sw)			
8.0	9.0	clay			
9.0	25.0	sand (sw)			
25.0	TD	End of borehole			

7 CONTRACTOR'S OR LANDOWNER'S CERTIFICATION: This water well was (1) constructed, (2) reconstructed, or (3) plugged under my jurisdiction and was completed on (mo/day/year) 8-4-97 and this record is true to the best of my knowledge and belief. Kansas Water Well Contractor's License No. 555 This Water Well Record was completed on (mo/day/year) 9-2-97 under the business name of ACT by (signature) [Signature]

OFFICE USE ONLY

T

R

EW

SEC.

1/4

1/4

1/4