


WATER WELL RECORD Form WWC-5 KSA 82a-1212

1 LOCATION OF WATER WELL: Fraction NE 1/4 NW 1/4 SE 1/4 Section Number 34 Township Number T 10 S Range Number R 25 EW  
 County: Wyandotte  
 Distance and direction from nearest town or city street address of well if located within city?  
In K.C.

2 WATER WELL OWNER: Highway Carriers  
 RR#, St. Address, Box #: 299 Donoban Rd  
 City, State, ZIP Code: K.C. Kansas  
 Board of Agriculture, Division of Water Resources  
 Application Number:

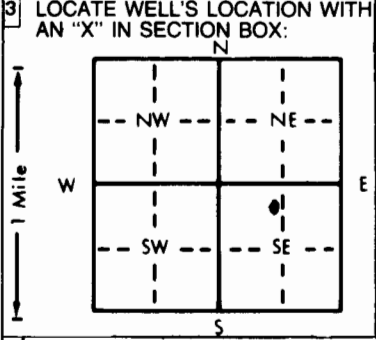

4 DEPTH OF COMPLETED WELL: 25' ft. ELEVATION: ..... ft.  
 Depth(s) Groundwater Encountered 1.17' ft. 2. .... ft. 3. .... ft.  
 WELL'S STATIC WATER LEVEL 14.14 ft. below land surface measured on mo/day/yr 9-11-98  
 Pump test data: Well water was ..... ft. after ..... hours pumping ..... gpm  
 Est. Yield ..... gpm; Well water was ..... ft. after ..... hours pumping ..... gpm  
 Bore Hole Diameter: 8 1/2" in. to 25" in. to ..... in. to ..... in. to ..... ft.  
 WELL WATER TO BE USED AS:  
 5 Public water supply 8 Air conditioning 11 Injection well  
 1 Domestic 3 Feedlot 6 Oil field water supply 9 Dewatering 12 Other (Specify below)  
 2 Irrigation 4 Industrial 7 Lawn and garden only 10 Monitoring well  
 Was a chemical/bacteriological sample submitted to Department? Yes.....No. X.....; If yes, mo/day/yr sample was submitted  
 Water Well Disinfected? Yes No

5 TYPE OF BLANK CASING USED:  
 1 Steel 2 PVC 3 RMP (SR) 4 ABS 5 Wrought iron 6 Asbestos-Cement 7 Fiberglass 8 Concrete tile 9 Other (specify below)  
 Blank casing diameter 2.375 in. to 10' ft., Dia ..... in. to ..... ft., Dia ..... in. to ..... ft.  
 Casing height above land surface Flush Mt. in., weight ..... lbs./ft. Wall thickness or gauge No. SDR-13 SCH 40  
 TYPE OF SCREEN OR PERFORATION MATERIAL:  
 1 Steel 2 Brass 3 Stainless steel 4 Galvanized steel 5 Fiberglass 6 Concrete tile 7 PVC 8 RMP (SR) 9 ABS 10 Asbestos-cement 11 Other (specify) 12 None used (open hole)  
 SCREEN OR PERFORATION OPENINGS ARE:  
 1 Continuous slot 2 Louvered shutter 3 Mill slot 4 Key punched 5 Gauzed wrapped 6 Wire wrapped 7 Torch cut 8 Saw cut 9 Drilled holes 11 None (open hole)  
 SCREEN-PERFORATED INTERVALS: From 25' ft. to 10' ft., From ..... ft. to ..... ft.  
 GRAVEL PACK INTERVALS: From 25' ft. to 8' ft., From ..... ft. to ..... ft.

6 GROUT MATERIAL: 1 Neat cement 2 Cement grout 3 Bentonite 4 Other  
 Grout Intervals: From 8' ft. to 4' ft., From 4' ft. to 0' ft., From ..... ft. to ..... ft.  
 What is the nearest source of possible contamination:  
 1 Septic tank 2 Sewer lines 3 Watertight sewer lines 4 Lateral lines 5 Cess pool 6 Seepage pit 7 Pit privy 8 Sewage lagoon 9 Feedyard 10 Livestock pens 11 Fuel storage Fueler 12 Fertilizer storage 13 Insecticide storage 14 Abandoned water well 15 Oil well/Gas well 16 Other (specify below)  
 Direction from well? East How many feet? 150'

FROM	TO	LITHOLOGIC LOG	FROM	TO	PLUGGING INTERVALS
0	1.25	Asphalt over LSR & Gravel			
1.25	5.50	Black silty clay to clayey silt gray banding, med. odor			
5.50	11.0	Brn silty clay to clayey silt			
11.0	17.0	Brn fine gravel part w/ some silt dirt, well rounded & sorted			
17.0	25.0	Med fine-med. grained sand, well sorted			

7 CONTRACTOR'S OR LANDOWNER'S CERTIFICATION: This water well was (1 constructed, (2) reconstructed, or (3) plugged under my jurisdiction and was completed on (mo/day/year) 9-11-98 and this record is true to the best of my knowledge and belief. Kansas Water Well Contractor's License No. 539 This Water Well Record was completed on (mo/day/yr) 10-1-98 under the business name of J. Ben. Drilling by signature James Baker