


1 LOCATION OF WATER WELL: County: **Wyandotte** Fraction: **NW 1/4 NW 1/4 SE 1/4** Section Number: **34** Township Number: **T 10 S** Range Number: **R 25 E/W**

Distance and direction from nearest town or city street address of well if located within city?
440' SE of Fairfax Tr. & Stanley Rd., KC, Kan.

2 WATER WELL OWNER: **MAGELLAN PIPELINE LLC**
 RR#, St. Address, Box #: **13424 WEST 98TH STREET** Board of Agriculture, Division of Water Resources
 City, State, ZIP Code: **SHAWNEE MISSION KS 66215** Application Number:

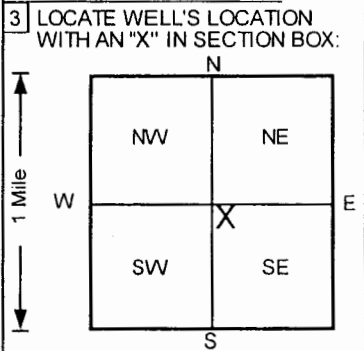

4 DEPTH OF COMPLETED WELL: **52** ft. ELEVATION: _____
 Depth(s) Groundwater Encountered 1. _____ ft. 2. _____ ft. 3. _____ ft.
 WELL'S STATIC WATER LEVEL: **20.98** ft. below land surface measured on **10/3/2003**
 Pump test data: Well water was **NA** ft. after _____ hours pumping _____ gpm
 Est. Yield **NA** gpm: Well water was _____ ft. after _____ hours pumping _____ gpm
 Bore Hole Diameter **8** in. to **52** ft. and _____ in. to _____ ft.
 WELL WATER TO BE USED AS: 5 Public water supply 8 Air conditioning 11 Injection well
 1 Domestic 3 Feedlot 6 Oil field water supply 9 Dewatering 12 Other (Specify below)
 2 Irrigation 4 Industrial 7 Lawn and garden only **10** Monitoring well
 Was a chemical/bacteriological sample submitted to Department? Yes _____ No
 Water Well Disinfected? Yes _____ No

5 TYPE OF BLANK CASING USED: 1 Steel 2 **PVC** 3 RMP (SR) 4 ABS 5 Wrought iron 6 Asbestos-Cement 7 Fiberglass 8 Concrete tile 9 Other (specify below) CASING JOINTS: Glued _____ Clamped _____ Welded _____ Threaded
 Blank casing diameter **2** in. to **42** ft. Dia _____ in. to _____ ft. Dia _____ in. to _____ ft.
 Casing height above land surface **0** in. weight _____ lbs./ft. Wall thickness or gauge No. **Sch. 40**
 TYPE OF SCREEN OR PERFORATION MATERIAL: 1 Steel 2 Brass 3 Stainless steel 4 Galvanized steel 5 Fiberglass 6 Concrete tile 7 **PVC** 8 RMP (SR) 9 ABS 10 Asbestos-cement 11 Other (specify) _____ 12 None used (open hole)
 SCREEN OR PERFORATION OPENINGS ARE: 1 Continuous slot 2 Louvered shutter 3 **Mill slot** 4 Key punched 5 Gauzed wrapped 6 Wire wrapped 7 Torch cut 8 Saw cut 9 Drilled holes 11 None (open hole) 10 Other (specify) _____
 SCREEN-PERFORATED INTERVALS: From **42** ft. to **52** ft. From _____ ft. to _____ ft. From _____ ft. to _____ ft.
 GRAVEL PACK INTERVALS: From **37** ft. to **52** ft. From _____ ft. to _____ ft. From _____ ft. to _____ ft.

6 GROUT MATERIAL: 1 **Neat cement** 2 **Cement grout** 3 **Bentonite** 4 Other _____
 Grout Intervals: From **0** ft. to **3** ft. From **3** ft. to **32** ft. From **32** ft. to **37** ft.
 What is the nearest source of possible contamination: 1 Septic tank 2 Sewer lines 3 Watertight sewer lines 4 Lateral lines 5 Cess pool 6 Seepage pit 7 Pit privy 8 Sewage lagoon 9 Feedyard 10 Livestock pens 11 Fuel storage 12 Fertilizer storage 13 Insecticide storage 14 Abandoned water well 15 Oil well/Gas well 16 Other (specify below) _____
 Direction from well? _____ How many feet? () _____

FROM	TO	LITHOLOGIC LOG	FROM	TO	PLUGGING INTERVALS
0	0.4	Asphalt,			
0.4	2	Gravel and Sand fill,			
2	3.5	Clay, medium plasticity, moist to damp, Black			
3.5	4.25	Clay, medium plasticity, moist to damp, Dark			
4.25	5.5	Clay, silty, medium to high plasticity, Dark Gr			
5.5	6.5	Clay, trace plasticity, damp, Dark Greenish G			
6.5	9.5	Silt, sandy, nonplastic, moist, Dark Grayish B			
9.5	10.5	Sand, silty, very fine grained, moist, Olive Bro			
10.5	13	Silt, sandy, nonplastic, moist, Olive Brown			
13	21.5	Sand, fine grained, trace silt, damp, Yellowish			
24.5	25	Sand, clayey, fine to medium grained, Gray			
25	52	Sand, clayey, fine to medium grained, Gray			
					MW-9D, Flushmount
					Project Name: BM - Mile Marker #1
					GeoCore # 1040, #

7 CONTRACTOR'S OR LANDOWNER'S CERTIFICATION: This water well was **1** constructed, (2) reconstructed, or (3) plugged under my jurisdiction and was completed on (mo/day/year) **9/25/2003** and this record is true to the best of my knowledge and belief.
 Kansas Water Well Contractor's License No. **527** This Water Well Record was completed on (mo/day/yr) **10/17/2003**
 under the business name of **GeoCore Inc.** by (signature) *[Signature]*

OFFICE USE ONLY