


1 LOCATION OF WATER WELL: County: Wyandotte	Fraction NW ¼ NW ¼ SE ¼	Section Number 34	Township Number T 10 S	Range Number R 25 E/W
---	-----------------------------------	-----------------------------	----------------------------------	---------------------------------

Distance and direction from nearest town or city street address of well if located within city?
400' SE of Fairfax Tr. & Stanley Rd., KC, Kan.

2 WATER WELL OWNER: **MAGELLAN PIPELINE LLC**
 RR#, St. Address, Box # : **13424 WEST 98TH STREET**
 City, State, ZIP Code : **SHAWNEE MISSION KS 66215**
 Board of Agriculture, Division of Water Resources
 Application Number:

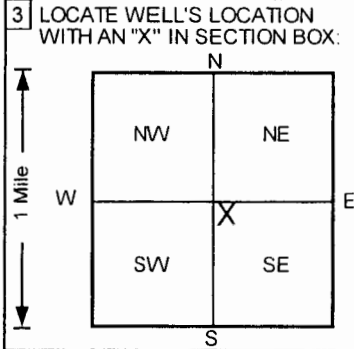

4 DEPTH OF COMPLETED WELL: **65** ft. ELEVATION: _____ ft.
 Depth(s) Groundwater Encountered 1. _____ ft. 2. _____ ft. 3. _____ ft.
 WELL'S STATIC WATER LEVEL: **22.52** ft. below land surface measured on mo/day/yr **9/29/2003**
 Pump test data: Well water was **NA** ft. after _____ hours pumping _____ gpm
 Est. Yield **NA** gpm: Well water was _____ ft. after _____ hours pumping _____ gpm
 Bore Hole Diameter **8** in. to **65** ft., and _____ in. to _____ ft.
 WELL WATER TO BE USED AS: 5 Public water supply 8 Air conditioning 11 Injection well
 1 Domestic 3 Feedlot 6 Oil field water supply 9 Dewatering 12 Other (Specify below)
 2 Irrigation 4 Industrial 7 Lawn and garden only **10 Monitoring well**
 Was a chemical/bacteriological sample submitted to Department? Yes _____ No
 Water Well Disinfected? Yes _____ No

5 TYPE OF CASING USED:
 1 Steel 3 RMP (SR) 5 Wrought iron 8 Concrete tile CASING JOINTS: Glued _____ Clamped _____
2 PVC 4 ABS 6 Asbestos-Cement 9 Other (specify below) Welded _____
 7 Fiberglass _____ Threaded
 Blank casing diameter **2** in. to **55** ft., Dia _____ in. to _____ ft., Dia _____ in. to _____ ft.
 Casing height above land surface **0** in, weight _____ lbs./ft. Wall thickness or gauge No. **Sch. 40**
 TYPE OF SCREEN OR PERFORATION MATERIAL **7 PVC** 10 Asbestos-cement
 1 Steel 3 Stainless steel 5 Fiberglass **8 RMP (SR)** 11 Other (specify) _____
 2 Brass 4 Galvanized steel 6 Concrete tile 9 ABS 12 None used (open hole)
 SCREEN OR PERFORATION OPENINGS ARE:
 1 Continuous slot **3 Mill slot** 5 Gauzed wrapped 8 Saw cut 11 None (open hole)
 2 Louvered shutter 4 Key punched 6 Wire wrapped 9 Drilled holes
 7 Torch cut 10 Other (specify) _____
 SCREEN-PERFORATED INTERVALS: From **55** ft. to **65** ft., From _____ ft. to _____ ft.
 From _____ ft. to _____ ft., From _____ ft. to _____ ft.
 GRAVEL PACK INTERVALS: From **52** ft. to **65** ft., From _____ ft. to _____ ft.
 From _____ ft. to _____ ft., From _____ ft. to _____ ft.

6 GROUT MATERIAL: **1 Neat cement** **2 Cement grout** **3 Bentonite** 4 Other _____
 Grout Intervals: From **0** ft. to **3** ft., From **3** ft. to **47** ft., From **47** ft. to **52** ft.
 What is the nearest source of possible contamination:
 1 Septic tank 4 Lateral lines 7 Pit privy 10 Livestock pens 14 Abandoned water well
 2 Sewer lines 5 Cess pool 8 Sewage lagoon 11 Fuel storage 15 Oil well/Gas well
 3 Watertight sewer lines 6 Seepage pit 9 Feedyard 12 Fertilizer storage 16 Other (specify below)
 13 Insecticide storage
 Direction from well? _____ How many feet? **0**

FROM	TO	LITHOLOGIC LOG	FROM	TO	PLUGGING INTERVALS
0	0.4	Asphalt,			
0.4	1	Gravel fill,			
1	3	Silt, sandy, some clay, trace plasticity, Dark G			
3	4	Clay, medium plasticity, damp, Black			
4	9	Clay, silty, medium plasticity, damp, Dark Gr			
9	10	Silt, sandy, trace clay, nonplastic, Dark Greeni			
10	13	Silt, clayey, nonplastic to trace plasticity, Dark			
13	13.5	Clay seam,			
13.5	14.5	Silt, nonplastic, wet, Dark Greenish Gray			
14.5	16.5	Sand, very fine to fine grained, Gray			
16.5	17.8	Sand, silty, very fine grained, Dark Greenish			
17.8	21.5	Sand, trace silt, very fine grained, Dark Green			
21.5	35	Sand, trace clay, very fine to fine grained, Dar			MW-11D, Flushmount
35	50	Sand, clayey, fine grained, wet, Dark Olive Gr			Project Name: BM - Mile Marker #1
50	65	Sand, clayey, fine to medium grained, Dark Ol			GeoCore # 1040, #

7 CONTRACTOR'S OR LANDOWNER'S CERTIFICATION: This water well was **1** constructed, (2) reconstructed, or (3) plugged under my jurisdiction and was completed on (mo/day/year) **9/23/2003** and this record is true to the best of my knowledge and belief.
 Kansas Water Well Contractor's License No. **527** This Water Well Record was completed on (mo/day/yr) **10/17/2003**
 under the business name of **GeoCore Inc.** by (signature) *[Signature]*

OFFICE USE ONLY