


1 LOCATION OF WATER WELL: County: Wyandotte	Fraction NW 1/4 NW 1/4 SE 1/4	Section Number 34	Township Number T 10 S	Range Number R 25 <u>E/W</u>
---	---	-----------------------------	----------------------------------	--

Distance and direction from nearest town or city street address of well if located within city?

400' SE of Fairfax Tr. & Stanley Rd., KC, Kan.

2 WATER WELL OWNER: RR#, St. Address, Box # City, State, ZIP Code	MAGELLAN PIPELINE LLC 13424 WEST 98 TH STREET SHAWNEE MISSION KS 66215	Board of Agriculture, Division of Water Resources Application Number:
---	---	--

3 LOCATE WELL'S LOCATION WITH AN "X" IN SECTION BOX:

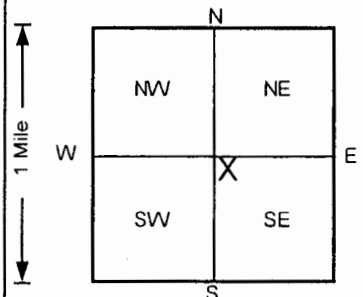

4 DEPTH OF COMPLETED WELL 25 ft. ELEVATION:	Depth(s) Groundwater Encountered 1. ft. 2. ft. 3. ft.
WELL'S STATIC WATER LEVEL 22.56 ft. below land surface measured on mo/day/yr 9/29/2003	
Pump test data: Well water was NA ft. after hours pumping gpm	
Est. Yield NA gpm: Well water was ft. after hours pumping gpm	
Bore Hole Diameter 8 in. to 25 ft., and in. to ft.	
WELL WATER TO BE USED AS: 5 Public water supply 8 Air conditioning 11 Injection well	
1 Domestic 3 Feedlot 6 Oil field water supply 9 Dewatering 12 Other (Specify below)	
2 Irrigation 4 Industrial 7 Lawn and garden only 10 Monitoring well	
Was a chemical/bacteriological sample submitted to Department? Yes.....No <input checked="" type="checkbox"/> ; If yes, mo/day/yr sample was submitted	
Water Well Disinfected? Yes No <input checked="" type="checkbox"/>	

5 TYPE OF BLANK CASING USED:	5 Wrought iron 8 Concrete tile	CASING JOINTS: Glued Clamped
1 Steel 3 RMP (SR)	6 Asbestos-Cement 9 Other (specify below)	Welded
2 PVC 4 ABS	7 Fiberglass	Threaded. <input checked="" type="checkbox"/>
Blank casing diameter 2 in. to 5 ft., Dia in. to ft., Dia in. to ft.	Casing height above land surface 0 in. weight lbs./ft. Wall thickness or gauge No. Sch. 40	
TYPE OF SCREEN OR PERFORATION MATERIAL		
1 Steel 3 Stainless steel 5 Fiberglass 7 PVC	8 RMP (SR)	10 Asbestos-cement
2 Brass 4 Galvanized steel 6 Concrete tile 9 ABS	11 Other (specify)	12 None used (open hole)
SCREEN OR PERFORATION OPENINGS ARE:		
1 Continuous slot 3 Mill slot	5 Gauzed wrapped	8 Saw cut 11 None (open hole)
2 Louvered shutter 4 Key punched	6 Wire wrapped	9 Drilled holes
7 Torch cut	10 Other (specify)	
SCREEN-PERFORATED INTERVALS: From 5 ft. to 25 ft., From ft. to ft.		
GRAVEL PACK INTERVALS: From 3 ft. to 25 ft., From ft. to ft.		

6 GROUT MATERIAL:	1 Neat cement 2 Cement grout 3 Bentonite 4 Other	Grout Intervals: From 0 ft. to 1.5 ft., From 1.5 ft. to 3 ft., From ft. to ft.
What is the nearest source of possible contamination:		
1 Septic tank 4 Lateral lines 7 Pit privy	10 Livestock pens 14 Abandoned water well	11 Fuel storage 15 Oil well/Gas well
2 Sewer lines 5 Cess pool 8 Sewage lagoon	12 Fertilizer storage 16 Other (specify below)	
3 Watertight sewer lines 6 Seepage pit 9 Feedyard	13 Insecticide storage	
Direction from well? How many feet? 0		

FROM	TO	LITHOLOGIC LOG	FROM	TO	PLUGGING INTERVALS
0	0.4	Asphalt,			
0.4	1	Gravel fill,			
1	3	Silt, sandy, some clay, trace plasticity, Dark G			
3	4	Clay, medium plasticity, damp, Black			
4	9	Clay, silty, medium plasticity, Dark Greenish			
9	10	Silt, sandy, trace clay, nonplastic, Dark Greeni			
10	13	Silt, clayey, nonplastic to trace plasticity, Dark			
13	13.5	Clay seam,			
13.5	14.5	Silt, nonplastic, wet, Dark Greenish Gray			
14.5	16.5	Sand, very fine to fine grained, Gray			
16.5	17.8	Sand, silty, very fine grained, Dark Greenish			
17.8	21.5	Sand, trace silt, very fine grained, Dark Gree			
21.5	25	Sand, trace silt, very fine to fine grained, Dark			
					MW-11S, Flushmount
					Project Name: BM - Mile Marker #1
					GeoCore # 1040, #

7 CONTRACTOR'S OR LANDOWNER'S CERTIFICATION: This water well was 1 constructed, 2 reconstructed, or 3 plugged under my jurisdiction and was completed on (mo/day/year) 9/23/2003 and this record is true to the best of my knowledge and belief.	Kansas Water Well Contractor's License No. 527 . This Water Well Record was completed on (mo/day/yr) 10/17/2003 under the business name of GeoCore Inc. by (signature) <i>[Signature]</i>
--	--