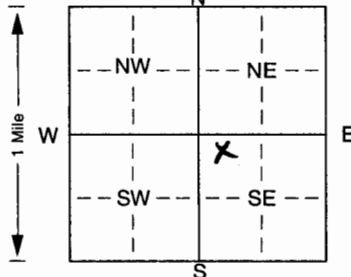


MW-18

1 LOCATION OF WATER WELL: Fraction NE 1/4 NW 1/4 SE 1/4 Section Number 34 Township Number T 10 S Range Number R 25 E  
 County: WYANDOTTE

Distance and direction from nearest town or city street address of well if located within city?  
INTERSECTION OF FAIRFAX TRAFFICWAY AND DONOVAN RD., KANSAS CITY, KS

2 WATER WELL OWNER: MAGELLAN PIPELINE COMPANY, LLC  
 RR#, St. Address, Box #: ONE WILLIAMS CENTER Board of Agriculture, Division of Water Resources  
 City, State, ZIP Code: TULSA, OK 74172 Application Number:

3 LOCATE WELL'S LOCATION WITH AN "X" IN SECTION BOX:  
  
 4 DEPTH OF COMPLETED WELL: 30 ft. ELEVATION:  
 Depth(s) Groundwater Encountered 1. . . . . ft. 2. . . . . ft. 3. . . . . ft.  
 WELL'S STATIC WATER LEVEL . . . . . ft. below land surface measured on mo/day/yr  
 Pump test data: Well water was . . . . . ft. after . . . . . hours pumping . . . . . gpm  
 Est. Yield . . . . . gpm: Well water was . . . . . ft. after . . . . . hours pumping . . . . . gpm  
 Bore Hole Diameter: 8 in. to 30 in. and . . . . . in. to . . . . . ft.  
 WELL WATER TO BE USED AS: 5 Public water supply 8 Air conditioning 11 Injection well  
 1 Domestic 3 Feedlot 6 Oil field water supply 9 Dewatering 12 Other (Specify below)  
 2 Irrigation 4 Industrial 7 Domestic (lawn & garden) 10 Monitoring well  
 Was a chemical/bacteriological sample submitted to Department? Yes. . . . . No. X; If yes, mo/day/yr sample was submitted  
 Water Well Disinfected? Yes NO

5 TYPE OF BLANK CASING USED:  
 1 Steel 3 RMP (SR) 5 Wrought iron 8 Concrete tile CASING JOINTS: Glued. . . . . Clamped. . . . .  
2 PVC 4 ABS 6 Asbestos-Cement 9 Other (specify below) Welded . . . . .  
 7 Fiberglass Threaded. X  
 Blank casing diameter 2 in. to 10 in. Dia . . . . . in. to . . . . . in. Dia . . . . . in. to . . . . . ft.  
 Casing height above land surface: 0 in., weight . . . . . lbs./ft. Wall thickness or gauge No. SCH. 40  
 TYPE OF SCREEN OR PERFORATION MATERIAL:  
 1 Steel 3 Stainless steel 5 Fiberglass 7 PVC 10 Asbestos-cement  
 2 Brass 4 Galvanized steel 6 Concrete tile 8 RMP (SR) 11 Other (specify) . . . . .  
 9 ABS 12 None used (open hole)  
 SCREEN OR PERFORATION OPENINGS ARE:  
 1 Continuous slot 3 Mill slot 5 Gauzed wrapped 8 Saw cut 11 None (open hole)  
 2 Louvered shutter 4 Key punched 6 Wire wrapped 9 Drilled holes  
 7 Torch cut 10 Other (specify) . . . . . ft.  
 SCREEN-PERFORATED INTERVALS: From 28.30 ft. to 10 ft. From . . . . . ft. to . . . . . ft.  
 From . . . . . ft. to . . . . . ft. From . . . . . ft. to . . . . . ft.  
 GRAVEL PACK INTERVALS: From 30 ft. to 8.5 ft. From . . . . . ft. to . . . . . ft.  
 From . . . . . ft. to . . . . . ft. From . . . . . ft. to . . . . . ft.

6 GROUT MATERIAL: 1 Neat cement 2 Cement grout 3 Bentonite 4 Other . . . . .  
 Grout Intervals: From 8.5 ft. to 1.0 ft., From . . . . . ft. to . . . . . ft., From . . . . . ft. to . . . . . ft.  
 What is the nearest source of possible contamination:  
 1 Septic tank 4 Lateral lines 7 Pit privy 10 Livestock pens 14 Abandoned water well  
 2 Sewer lines 5 Cess pool 8 Sewage lagoon 11 Fuel storage 15 Oil well/Gas well  
 3 Watertight sewer lines 6 Seepage pit 9 Feedyard 12 Fertilizer storage 16 Other (specify below)  
 13 Insecticide storage . . . . .  
 Direction from well? How many feet?

FROM	TO	LITHOLOGIC LOG	FROM	TO	PLUGGING INTERVALS
0	3.8	FILL - CLAY, GRAVEL, ASPHALT			
3.8	9.4	DK. BROWN SILTY CLAY			
9.4	10.4	DK. BROWN SILT			
10.4	17.2	DK. BROWN SILTY SAND			
17.2	18.4	DK. BROWN SILT			
18.4	30	DK. BROWN SAND, FINE-GRAINED.			

7 CONTRACTOR'S OR LANDOWNER'S CERTIFICATION: This water well was (1) constructed, (2) reconstructed, or (3) plugged under my jurisdiction and was completed on (mo/day/year) 10/15/2004 and this record is true to the best of my knowledge and belief. Kansas Water Well Contractor's Licence No. 529 This Water Well Record was completed on (mo/day/yr) 10/29/2004 under the business name of GEOTECHNOLOGY, INC. by (signature)