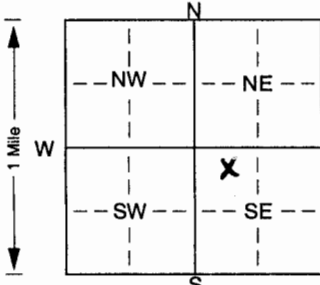


1 LOCATION OF WATER WELL: Fraction <u>NE 1/4 NW 1/4 SE 1/4</u> Section Number <u>34</u> Township Number <u>T 10 S</u> Range Number <u>R 25 E</u>					
County: <u>WYANDOTTE</u>					
Distance and direction from nearest town or city street address of well if located within city? <u>INTERSECTION OF FAIRFAR TRAFFICWAY AND DONOVAN RD., KANSAS CITY, KS</u>					
2 WATER WELL OWNER: <u>MAGELLAN PIPELINE COMPANY, LLC</u>					
RR#, St. Address, Box #: <u>ONE WILLIAMS CENTER</u>					
City, State, ZIP Code: <u>TULSA, OK 74172</u>					
Board of Agriculture, Division of Water Resources Application Number:					
3 LOCATE WELL'S LOCATION WITH AN "X" IN SECTION BOX:	4 DEPTH OF COMPLETED WELL: <u>25.0</u> ft. ELEVATION:				
<div style="text-align: center;"></div>	Depth(s) Groundwater Encountered 1. ft. 2. ft. 3. ft. WELL'S STATIC WATER LEVEL ft. below land surface measured on mo/day/yr Pump test data: Well water was ft. after hours pumping gpm Est. Yield gpm Well water was ft. after hours pumping gpm Bore Hole Diameter. <u>8</u> in. to <u>25.0</u> ft., and in. to ft. WELL WATER TO BE USED AS: 5 Public water supply 8 Air conditioning 11 Injection well 1 Domestic 3 Feedlot 6 Oil field water supply 9 Dewatering 12 Other (Specify below) 2 Irrigation 4 Industrial 7 Domestic (lawn & garden) 10 Monitoring well Was a chemical/bacteriological sample submitted to Department? Yes. No. <u>X</u> ; If yes, mo/day/yr sample was submitted Water Well Disinfected? Yes No <u>X</u>				
5 TYPE OF BLANK CASING USED: 1 Steel 3 RMP (SR) 5 Wrought iron 8 Concrete tile CASING JOINTS: Glued. Clamped. 2 <u>PVC</u> 4 ABS 6 Asbestos-Cement 9 Other (specify below) Welded Blank casing diameter <u>2</u> in. to <u>25</u> ft., Dia in. to ft., Dia in. to ft. Casing height above land surface. <u>0</u> in., weight <u>SC440</u> lbs./ft. Wall thickness or gauge No. <u>SC440</u> TYPE OF SCREEN OR PERFORATION MATERIAL: 1 Steel 3 Stainless steel 5 Fiberglass 8 RMP (SR) 10 Asbestos-cement 2 Brass 4 Galvanized steel 6 Concrete tile 9 ABS 11 Other (specify) 12 None used (open hole) SCREEN OR PERFORATION OPENINGS ARE: 1 Continuous slot 3 <u>Mill slot</u> 5 Gauzed wrapped 8 Saw cut 11 None (open hole) 2 Louvered shutter 4 Key punched 6 Wire wrapped 9 Drilled holes 7 Torch cut 10 Other (specify) SCREEN-PERFORATED INTERVALS: From <u>25</u> ft. to <u>5</u> ft., From ft. to ft. GRAVEL PACK INTERVALS: From <u>25</u> ft. to <u>3.5</u> ft., From ft. to ft. From ft. to ft., From ft. to ft.					
6 GROUT MATERIAL: 1 Neat cement 2 Cement grout 3 <u>Bentonite</u> 4 Other Grout Intervals: From <u>3.5</u> ft. to <u>1.0</u> ft., From ft. to ft., From ft. to ft. What is the nearest source of possible contamination: 10 Livestock pens 14 Abandoned water well 1 Septic tank 4 Lateral lines 7 Pit privy 11 Fuel storage 15 Oil well/Gas well 2 Sewer lines 5 Cess pool 8 Sewage lagoon 12 Fertilizer storage 16 Other (specify below) 3 Watertight sewer lines 6 Seepage pit 9 Feedyard 13 Insecticide storage Direction from well? How many feet?					
FROM	TO	LITHOLOGIC LOG	FROM	TO	PLUGGING INTERVALS
0	0.4	ASPHALT			
0.4	3.6	DK. GRAY SILTY CLAY			
3.6	12.2	DK. GRAY SANDY SILT			
12.2	17.4	DK. GRAY CLAY			
17.4	25.0	DK. GRAY SAND, FINEGRAINED			
7 CONTRACTOR'S OR LANDOWNER'S CERTIFICATION: This water well was (1) constructed, (2) reconstructed, or (3) plugged under my jurisdiction and was completed on (mo/day/year) <u>8-19-04</u> and this record is true to the best of my knowledge and belief. Kansas Water Well Contractor's Licence No. <u>529</u> This Water Well Record was completed on (mo/day/yr) <u>10/15/2009</u> under the business name of <u>GEOTECHNOLOGY, INC.</u> by (signature) <u>[Signature]</u>					