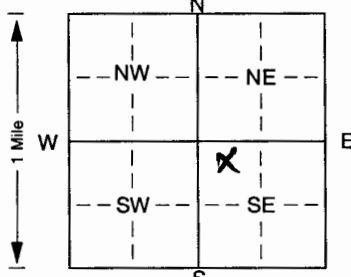


1] LOCATION OF WATER WELL: Fraction NE 1/4 NW 1/4 SE 1/4 Section Number 34 Township Number T 10 S Range Number R 25 E
 County: WYANDOTTE

Distance and direction from nearest town or city street address of well if located within city?
INTERSECTION OF FAIRFAK TRAFFICWAY AND DONOVAN RD., KANSAS CITY, KS

2] WATER WELL OWNER: MAGELLAN PIPELINE COMPANY, LLC
 RR#, St. Address, Box #: ONE WILLIAMS CENTER Board of Agriculture, Division of Water Resources
 City, State, ZIP Code: TULSA, OK 74172 Application Number:

3] LOCATE WELL'S LOCATION WITH AN "X" IN SECTION BOX:  4] DEPTH OF COMPLETED WELL: 25 ft. ELEVATION: _____
 Depth(s) Groundwater Encountered 1. _____ ft. 2. _____ ft. 3. _____ ft.
 WELL'S STATIC WATER LEVEL _____ ft. below land surface measured on mo/day/yr _____
 Pump test data: Well water was _____ ft. after _____ hours pumping _____ gpm
 Est. Yield _____ gpm: Well water was _____ ft. after _____ hours pumping _____ gpm
 Bore Hole Diameter: 8 in. to 2.5 ft., and _____ in. to _____ ft.
 WELL WATER TO BE USED AS: 5 Public water supply 8 Air conditioning 11 Injection well
 1 Domestic 3 Feedlot 6 Oil field water supply 9 Dewatering 12 Other (Specify below)
 2 Irrigation 4 Industrial 7 Domestic (lawn & garden) 10 Monitoring well _____
 Was a chemical/bacteriological sample submitted to Department? Yes. _____ No. X; If yes, mo/day/yr sample was sub-
 mitted _____ Water Well Disinfected? Yes _____ No X

5] TYPE OF BLANK CASING USED: 1 Steel 2 PVC 3 RMP (SR) 4 ABS 5 Wrought iron 6 Asbestos-Cement 7 Fiberglass 8 Concrete tile 9 Other (specify below) CASING JOINTS: Glued _____ Clamped _____ Welded _____ Threaded X
 Blank casing diameter 2 in. to 5 ft., Dia _____ in. to _____ ft., Dia _____ in. to _____ ft.
 Casing height above land surface: 0 in., weight SRH 40 lbs./ft. Wall thickness or gauge No. _____
 TYPE OF SCREEN OR PERFORATION MATERIAL: PVC 10 Asbestos-cement 11 Other (specify) _____ 12 None used (open hole)
 1 Steel 3 Stainless steel 5 Fiberglass 8 RMP (SR) 9 ABS
 2 Brass 4 Galvanized steel 6 Concrete tile 7 Torch cut 10 Other (specify) _____
 SCREEN OR PERFORATION OPENINGS ARE: 1 Continuous slot 5 Mill slot 2 Louvered shutter 3 Key punched 4 Key punched 5 Gauzed wrapped 6 Wire wrapped 7 Torch cut 8 Saw cut 9 Drilled holes 11 None (open hole)
 SCREEN-PERFORATED INTERVALS: From 25 ft. to 5 ft., From _____ ft. to _____ ft.
 GRAVEL PACK INTERVALS: From 25 ft. to 3.5 ft., From _____ ft. to _____ ft.

6] GROUT MATERIAL: 1 Neat cement 2 Cement grout Bentonite 4 Other _____
 Grout Intervals: From 3.5 ft. to 1.0 ft., From _____ ft. to _____ ft., From _____ ft. to _____ ft.
 What is the nearest source of possible contamination:
 1 Septic tank 4 Lateral lines 7 Pit privy 10 Livestock pens 14 Abandoned water well
 2 Sewer lines 5 Cess pool 8 Sewage lagoon 11 Fuel storage 15 Oil well/Gas well
 3 Watertight sewer lines 6 Seepage pit 9 Feedyard 12 Fertilizer storage 16 Other (specify below)
 13 Insecticide storage _____
 Direction from well? _____ How many feet? _____

FROM	TO	LITHOLOGIC LOG	FROM	TO	PLUGGING INTERVALS
0	0.4	ASPHALT			
0.4	7.8	DK. GRAY SILTY CLAY			
7.8	9.4	BROWN SILT			
9.4	12.0	GRAY BROWN SAND, FINE GRAINED			
12.0	14.0	GRAY BROWN SILT			
14.0	22.5	GRAY BROWN SAND, FINE GRAINED			
22.5	25.0	DK. GREEN GRAY SAND, MED. GRAINED			

7] CONTRACTOR'S OR LANDOWNER'S CERTIFICATION: This water well was (1) constructed, (2) reconstructed, or (3) plugged under my jurisdiction and was completed on (mo/day/year) 8-17-04 and this record is true to the best of my knowledge and belief. Kansas Water Well Contractor's Licence No. 529 This Water Well Record was completed on (mo/day/yr) 10/15/2004 under the business name of GEOTECHNOLOGY, INC. by (signature) 