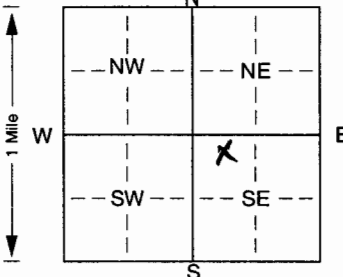


1] LOCATION OF WATER WELL: Fraction NE 1/4 NW 1/4 SE 1/4 Section Number 34 Township Number T 10 S Range Number R 25 E/W
 County: WYANDOTTE

Distance and direction from nearest town or city street address of well if located within city?
INTERSECTION OF FAIRFAX TRAFFICWAY AND DONOVAN RO., KANSAS CITY, KS

2] WATER WELL OWNER: MAGELLAN PIPELINE COMPANY, LLC
 RR#, St. Address, Box #: ONE WILLIAMS CENTER Board of Agriculture, Division of Water Resources
 City, State, ZIP Code: TULSA, OK 74172 Application Number:

3] LOCATE WELL'S LOCATION WITH AN "X" IN SECTION BOX:

 4] DEPTH OF COMPLETED WELL: 58.5 ft. ELEVATION:
 Depth(s) Groundwater Encountered 1. ft. 2. ft. 3. ft.
 WELL'S STATIC WATER LEVEL ft. below land surface measured on mo/day/yr
 Pump test data: Well water was ft. after hours pumping gpm
 Est. Yield gpm: Well water was ft. after hours pumping gpm
 Bore Hole Diameter: 8 in. to 58.5 ft., and in. to ft.
 WELL WATER TO BE USED AS: 5 Public water supply 8 Air conditioning 11 Injection well
 1 Domestic 3 Feedlot 6 Oil field water supply 9 Dewatering 12 Other (Specify below)
 2 Irrigation 4 Industrial 7 Domestic (lawn & garden) 10 Monitoring well
 Was a chemical/bacteriological sample submitted to Department? Yes. No. X ; If yes, mo/day/yr sample was submitted
 Water Well Disinfected? Yes No. X

5] TYPE OF BLANK CASING USED:
 1 Steel 3 RMP (SR) 5 Wrought iron 8 Concrete tile CASING JOINTS: Glued. Clamped.
2 PVC 4 ABS 6 Asbestos-Cement 9 Other (specify below) Welded
 7 Fiberglass Threaded. X
 Blank casing diameter 2 in. to 48.5 ft., Dia in. to ft., Dia in. to ft.
 Casing height above land surface: 0 in., weight 3.440 lbs./ft. Wall thickness or gauge No.
 TYPE OF SCREEN OR PERFORATION MATERIAL: 7 PVC 10 Asbestos-cement
 1 Steel 3 Stainless steel 5 Fiberglass 8 RMP (SR) 11 Other (specify)
 2 Brass 4 Galvanized steel 6 Concrete tile 9 ABS 12 None used (open hole)
 SCREEN OR PERFORATION OPENINGS ARE:
 1 Continuous slot 3 Mill slot 5 Gauzed wrapped 8 Saw cut 11 None (open hole)
 2 Louvered shutter 4 Key punched 6 Wire wrapped 9 Drilled holes
 7 Torch cut 10 Other (specify) ft.
 SCREEN-PERFORATED INTERVALS: From: 58.5 ft. to 48.5 ft., From ft. to ft.
 From: 0 ft. to ft., From ft. to ft.
 GRAVEL PACK INTERVALS: From: 58.5 ft. to 46.5 ft., From ft. to ft.
 From: ft. to ft., From ft. to ft.

6] GROUT MATERIAL: 1 Neat cement 2 Cement grout 3 Bentonite 4 Other
 Grout Intervals: From: 46.5 ft. to 1.0 ft., From ft. to ft., From ft. to ft.
 What is the nearest source of possible contamination:
 1 Septic tank 4 Lateral lines 7 Pit privy 10 Livestock pens 14 Abandoned water well
 2 Sewer lines 5 Cess pool 8 Sewage lagoon 11 Fuel storage 15 Oil well/Gas well
 3 Watertight sewer lines 6 Seepage pit 9 Feedyard 12 Fertilizer storage 16 Other (specify below)
 13 Insecticide storage
 Direction from well? How many feet?

FROM	TO	LITHOLOGIC LOG	FROM	TO	PLUGGING INTERVALS
0	0.4	ASPHALT			
0.4	11.6	DK. GRAY SILTY CLAY			
11.6	23.8	DK. GRAY SAND, FINE TO MED. GRAINED			
23.8	25.0	GREEN GRAY SILT			
25.0	55.0	DK. GREEN GRAY SAND, MED. TO COARSE GRAINED			
55.0	58.5	GRAVEL, MEDIUM-GRAINED			
58.5	60.0	GRAY LIMESTONE			

7] CONTRACTOR'S OR LANDOWNER'S CERTIFICATION: This water well was (1) constructed, (2) reconstructed, or (3) plugged under my jurisdiction and was completed on (mo/day/year) 8-17-04 and this record is true to the best of my knowledge and belief. Kansas Water Well Contractor's Licence No. 529. This Water Well Record was completed on (mo/day/yr) 10/15/2004 under the business name of GEOTECHNOLOGY, INC. by (signature) [Signature]