WATER WELL RECORD Form WWC-5 KSA 82a-1212 ID No. AS-87

1 LOCATION OF WATER WELL: County: Wyandotte	Fraction: SW ¼ SW ¼ SW ¼	Section Number: 27	Township Number: T 10 (S)	Range Number: R 25 (E) W

Distance and direction from nearest town or city street address of well if located within city?
1/2 Block North of Funston Rd. & Brinkerhoff Rd. Kansas City, KS 66115

2 WATER WELL OWNER: Dow Chemical Corp.
RR#, St. Address, Box #: P.O. Box 8361-3200 Kanawha Turnpike
City, State, ZIP Code: South Charleston, WV 25303

Board of Agriculture, Division of Water Resources Application Number:

3 LOCATE WELL'S LOCATION WITH AN "X" IN SECTION BOX:

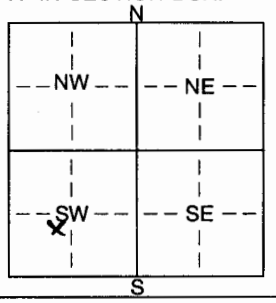

4 DEPTH OF COMPLETED WELL: 44.0 ft. ELEVATION:
Depth(s) Groundwater Encountered 1. 23.0 ft. 2. ft. 3. ft.
WELL'S STATIC WATER LEVEL ft. below land surface measured on mo/day/yr
Pump test data: Well water was ft. after hours pumping gpm
Est. Yield gpm: Well water was ft. after hours pumping gpm
Bore Hole Diameter 3.25 in. to ft., and in. to ft.
WELL WATER TO BE USED AS: 5 Public water supply 8 Air conditioning (11) Injection well
1 Domestic 3 Feedlot 6 Oil field water supply 9 Dewatering (12) Other (Specify below)
2 Irrigation 4 Industrial 7 Domestic (lawn & garden) 10 Monitoring well Air Sparge
Was a chemical/bacteriological sample submitted to Department? Yes (No) X; If yes, mo/day/yrs sample was submitted
Water Well Disinfected? Yes (No) X

5 TYPE OF BLANK CASING USED: 5 Wrought iron 8 Concrete tile CASING JOINTS: Glued Clamped
1 Steel 3 RMP (SR) 6 Asbestos-Cement 9 Other (specify below) Welded
(2) PVC 4 ABS 7 Fiberglass Threaded
Blank casing diameter 1" in. to 43' ft., Dia in. to ft., Dia in. to ft.
Casing height above land surface 24 in., weight lbs./ft. Wall thickness or gauge No. Sch. 40

TYPE OF SCREEN OR PERFORATION MATERIAL: (7) PVC 10 Asbestos-cement
1 Steel 3 Stainless steel 5 Fiberglass 8 RMP (SR) 11 Other (specify)
2 Brass 4 Galvanized steel 6 Concrete tile 9 ABS 12 None used (open hole)

SCREEN OR PERFORATION OPENINGS ARE: 5 Gauzed wrapped 8 Saw cut 11 None (open hole)
1 Continuous slot (3) Mill slot 6 Wire wrapped 9 Drilled holes
2 Louvered shutter 4 Key punched 7 Torch cut 10 Other (specify) ft.

SCREEN-PERFORATED INTERVALS: From 43 ft. to 44 ft., From ft. to ft.
From ft. to ft., From ft. to ft.
GRAVEL PACK INTERVALS: From 44 ft. to 42 ft., From 42 ft. to 40 ft.
From ft. to ft., From ft. to ft.

6 GROUT MATERIAL: (1) Neat cement (2) Cement grout 3 Bentonite 4 Other
Grout Intervals: From 8 ft. to Surface ft., From 40 ft. to 8 ft., From ft. to ft.
What is the nearest source of possible contamination: 10 Livestock pens 14 Abandoned water well
1 Septic tank 4 Lateral lines 7 Pit privy 11 Fuel storage 15 Oil well/Gas well
2 Sewer lines 5 Cess pool 8 Sewage lagoon 12 Fertilizer storage (16) Other (specify below)
3 Watertight sewer lines 6 Seepage pit 9 Feedyard 13 Insecticide storage Old Air Sparge Points
Direction from well? How many feet?

FROM	TO	LITHOLOGIC LOG	FROM	TO	PLUGGING INTERVALS
0	5	Brown, Hard, Dry - Lean Clay			
5	10	Dk Brown, Moist, Silty Lean Clay			
10	20	Moist, Lean Clay w/ Trace of Fine Sand			
20	25	Medium Grained Sand - Moist Grey			
25	30	Dk Grey Med to Fine Grained Sand, Wet			
30	40	Fine Grained Sand, Wet, Dk Grey			
40	44	" "			

7 CONTRACTOR'S OR LANDOWNER'S CERTIFICATION: This water well was (1) constructed, (2) reconstructed, or (3) plugged under my jurisdiction and was completed on (mo/day/year) 11-5-04 and this record is true to the best of my knowledge and belief. Kansas Water Well Contractor's Licence No. 606 This Water Well Record was completed on (mo/day/yr) 11-15-04 under the business name of PSA Environmental by (signature)

INSTRUCTIONS: Use typewriter or ball point pen. *PLEASE PRESS FIRMLY* and *PRINT* clearly. Please fill in blanks, underline or circle the correct answers. Send top three copies to Kansas Department of Health and Environment, Bureau of Water, Topeka, Kansas 66620-0001. Telephone 785-296-5524. Send one to WATER WELL OWNER and retain one for your records. Fee of $5.00 for each constructed well.