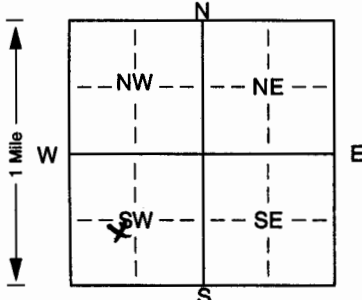


AS-97

1 LOCATION OF WATER WELL: Fraction SW 1/4 SW 1/4 SW 1/4 Section Number 27 Township Number T 10 S Range Number R 25 EW
 County: Wyandotte

Distance and direction from nearest town or city street address of well if located within city?
1/2 Block North of Funston Rd & Brinkerhoff Rd Kansas City, KS

2 WATER WELL OWNER: Pow Chemical Corp.
 RR#, St. Address, Box #: P.O. Box 8361-3200 Kanawha Turnpike Board of Agriculture, Division of Water Resources
 City, State, ZIP Code: South Charleston, WV 25303 Application Number:

3 LOCATE WELL'S LOCATION WITH AN "X" IN SECTION BOX:

 4 DEPTH OF COMPLETED WELL: 45.0 ft. ELEVATION:
 Depth(s) Groundwater Encountered 1. 25.0 ft. 2. ft. 3. ft.
 WELL'S STATIC WATER LEVEL 25.83 ft. below land surface measured on mo/day/yr 11-12-04
 Pump test data: Well water was ft. after hours pumping gpm
 Est. Yield gpm: Well water was ft. after hours pumping gpm
 Bore Hole Diameter 3.25 in. to ft., and in. to ft.
 WELL WATER TO BE USED AS: 5 Public water supply 8 Air conditioning Injection well
 1 Domestic 3 Feedlot 6 Oil field water supply 9 Dewatering Other (Specify below)
 2 Irrigation 4 Industrial 7 Domestic (lawn & garden) 10 Monitoring well for sprays
 Was a chemical/bacteriological sample submitted to Department? Yes No ; if yes, mo/day/yr sample was submitted
 Water Well Disinfected? Yes No

5 TYPE OF BLANK CASING USED: 1 Steel 3 RMP (SR) 5 Wrought iron 8 Concrete tile CASING JOINTS: Glued. Clamped. Welded. Threaded.
 PVC 4 ABS 6 Asbestos-Cement 9 Other (specify below)
 Blank casing diameter 1" in. to 44" ft., Dia. in. to ft., Dia. in. to ft.
 Casing height above land surface 24 in., weight lbs./ft. Wall thickness or gauge No. Sch. 40
 TYPE OF SCREEN OR PERFORATION MATERIAL: PVC 10 Asbestos-cement
 1 Steel 3 Stainless steel 5 Fiberglass 8 RMP (SR) 11 Other (specify)
 2 Brass 4 Galvanized steel 6 Concrete tile 9 ABS 12 None used (open hole)
 SCREEN OR PERFORATION OPENINGS ARE: 5 Gauzed wrapped 8 Saw cut 11 None (open hole)
 1 Continuous slot Mill slot 6 Wire wrapped 9 Drilled holes
 2 Louvered shutter 4 Key punched 7 Torch cut 10 Other (specify) ft.
 SCREEN-PERFORATED INTERVALS: From 44 ft. to 45 ft., From ft. to ft.
 GRAVEL PACK INTERVALS: From 45 ft. to 43 ft., From 43 ft. to 44 ft.

6 GROUT MATERIAL: Neat cement Cement grout 3 Bentonite 4 Other
 Grout Intervals: From 8 ft. to Surface ft., From 40 ft. to 8 ft., From ft. to ft.
 What is the nearest source of possible contamination:
 1 Septic tank 4 Lateral lines 7 Pit privy 10 Livestock pens 14 Abandoned water well
 2 Sewer lines 5 Cess pool 8 Sewage lagoon 11 Fuel storage 15 Oil well/Gas well
 3 Watertight sewer lines 6 Seepage pit 9 Feedyard 12 Fertilizer storage Other (specify below)
 13 Insecticide storage
 Direction from well? How many feet?

| FROM | TO | LITHOLOGIC LOG | FROM | TO | PLUGGING INTERVALS |
|------|----|--|------|----|--------------------|
| 0 | 5 | Clay-lean, Hard, brown, Dry | | | |
| 5 | 10 | Lean Clay, moist, DK Brown, Silty | | | |
| 10 | 20 | Lean clay, trace fine sand, moist | | | |
| 20 | 30 | Med to fine grained sand, wet, DK grey | | | |
| 30 | 40 | DK grey, fine grained sand, wet | | | |
| 40 | 45 | " " | | | |

7 CONTRACTOR'S OR LANDOWNER'S CERTIFICATION: This water well was constructed, (2) reconstructed, or (3) plugged under my jurisdiction and was completed on (mo/day/year) 11-4-04 and this record is true to the best of my knowledge and belief. Kansas
 Water Well Contractor's Licence No. 606 This Water Well Record was completed on (mo/day/yr) 11-15-04
 under the business name of PSA Environmental by (signature) [Signature]