


1 LOCATION OF WATER WELL: County: Wyandotte Fraction: SE SE SE Section Number: 28 Township Number: 10 Range Number: 25 EW

Distance and direction from nearest town or city street address of well if located within city?
3150 N 7th St TFWY

2 WATER WELL OWNER: BFI Waste Systems MW 9
 RR #, St. Address, Box #: 3150 N 7th St TFWY
 City, State, ZIP Code: PC KS Board of Agriculture, Division of Water Resources
 Application Number: _____

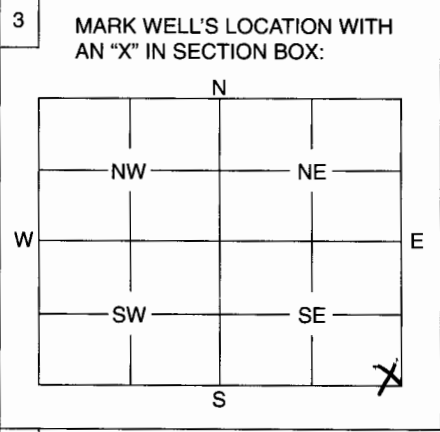

4 DEPTH OF WELL 24 ft.
 WELL'S STATIC WATER LEVEL ft.
 WELL WAS USED AS:
 1 Domestic 5 Public Water Supply
 2 Irrigation 6 Oil Field Water Supply
 3 Feedlot 7 Domestic (Lawn & Garden)
 4 Industrial 8 Air Conditioning
 9 Dewatering
 10 Monitoring Well
 11 Injection Well
 12 Other

Was a chemical / bacteriological sample submitted to Department? Yes No X.....
 If yes, mo/day/yr sample was submitted

Water Well Disinfected: Yes No X.....

5 TYPE OF BLANK CASING USED:
 1 Steel 3 RMP (SR) 5 Wrought 7 Fiberglass 9 Other (Specify below)
 2 PVC 4 ABS 6 Asbestos-Cement 8 Concrete Tile

Blank casing diameter 2 in. Was casing pulled? Yes X No If yes, how much

Casing height above or below land surface 0 in.

6 GROUT PLUG MATERIAL: 1 Neat cement 2 Cement grout 3 Bentonite 4 Other

Grout Plug Intervals: From ~2 ft. to 20 ft., From ft. to ft., From to ft.

What is the nearest source of possible contamination:
 1 Septic tank 6 Seepage pit
 2 Sewer lines 7 Pit privy
 3 Watertight sewer lines 8 Sewage lagoon
 4 Lateral lines 9 Feedyard
 5 Cess pool 10 Livestock pens
 11 Fuel storage 16 Other (specify below)
 12 Fertilizer storage
 13 Insecticide storage
 14 Abandoned water well
 15 Oil well/Gas well

Direction from well? How many feet?

FROM	TO	PLUGGING MATERIALS
<u>0</u>	<u>2</u>	<u>Cement</u>
<u>~2</u>	<u>20</u>	<u>Bentonite grout</u>

7 CONTRACTOR'S OF LANDOWNER'S CERTIFICATION: This water well was plugged under my jurisdiction and was completed on (mo/day/year) 1/10/05 and this record is true to the best of my knowledge and belief. Kansas Water Well Contractor's License No. 602 This Water Well Record was completed on (mo/day/year) under the business name of Hydrologic Inc. by (signature) [Signature]

INSTRUCTIONS: Use typewriter or ball point pen. Please press firmly and print clearly. Please fill in blanks, underline or circle the correct answers. Send top three copies to Kansas Department of Health and Environment, Bureau of Water, Geology Section, 1000 SW Jackson St., Ste. 420, Topeka, Kansas 66612-1367. Telephone: 785/296-5522. Send one to Water Well Owner and retain one for your records.