


1 LOCATION OF WATER WELL: County: Wyandotte Fraction: SE 1/4 SE 1/4 SE 1/4 Section Number: 28 Township Number: T 10 S Range Number: R 25 EW

Distance and direction from nearest town or city street address of well if located within city?

3150 N 7th St TFWY

2 WATER WELL OWNER: BFI Waste Systems RR#, St. Address, Box # : 3150 N 7th St TFWY City, State, ZIP Code : MW2R Board of Agriculture, Division of Water Resources Application Number:

3 LOCATE WELL'S LOCATION WITH AN "X" IN SECTION BOX: 4 DEPTH OF COMPLETED WELL 34 ft. ELEVATION:

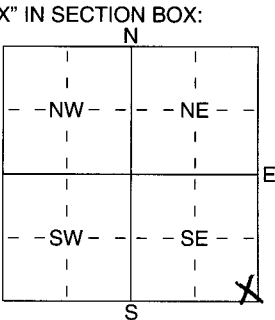

Depth(s) Groundwater Encountered 1 ..... ft. 2 ..... ft. 3 ..... ft.  
 WELL'S STATIC WATER LEVEL ..... ft. below land surface measured on mo/day/yr .....  
 Pump test data: Well water was ..... ft. after ..... hours pumping ..... gpm  
 Est. Yield ..... gpm: Well water was ..... ft. after ..... hours pumping ..... gpm  
 WELL WATER TO BE USED AS:  
 1 Domestic 2 Irrigation 3 Feedlot 4 Industrial 5 Public water supply 6 Oil field water supply 7 Domestic (lawn & garden) 8 Air conditioning 9 Dewatering 10 Monitoring well 11 Injection well 12 Other (Specify below)

Was a chemical/bacteriological sample submitted to Department? Yes ..... No .....; If yes, mo/day/yr sample was submitted Water Well Disinfected? Yes ..... No .....

5 TYPE OF BLANK CASING USED: 1 Steel 2 PVC 3 RMP (SR) 4 ABS 5 Wrought iron 6 Asbestos-Cement 7 Fiberglass 8 Concrete tile 9 Other (specify below) CASING JOINTS: Glued ..... Clamped ..... Welded ..... Threaded .....

Blank casing diameter ..... in. to ..... ft., Dia ..... in. to ..... ft., Dia ..... in. to ..... ft.  
 Casing height above land surface ..... in., weight ..... lbs./ft. Wall thickness or gauge No. ....

TYPE OF SCREEN OR PERFORATION MATERIAL: 1 Steel 2 Brass 3 Stainless Steel 4 Galvanized Steel 5 Fiberglass 6 Concrete tile 7 PVC 8 RMP (SR) 9 ABS 10 Asbestos-Cement 11 Other (Specify) ..... 12 None used (open hole)

SCREEN OR PERFORATION OPENINGS ARE: 1 Continuous slot 2 Louvered shutter 3 Mill slot 4 Key punched 5 Gauzed wrapped 6 Wire wrapped 7 Torch cut 8 Saw cut 9 Drilled holes 10 Other (specify) ..... ft. 11 None (open hole)

SCREEN-PERFORATED INTERVALS: From 17 ft. to 32 ft., From ..... ft. to ..... ft.  
 GRAVEL PACK INTERVALS: From 15 ft. to 34 ft., From ..... ft. to ..... ft.

6 GROUT MATERIAL: 1 Neat cement 2 Cement grout 3 Bentonite 4 Other Cement 0-2'  
 Grout Intervals: From 2 ft. to 15 ft., From ..... ft. to ..... ft., From ..... ft. to ..... ft.

What is the nearest source of possible contamination:  
 1 Septic tank 2 Sewer lines 3 Watertight sewer lines 4 Lateral lines 5 Cess pool 6 Seepage pit 7 Pit privy 8 Sewage lagoon 9 Feedyard 10 Livestock pens 11 Fuel storage Former 12 Fertilizer storage 13 Insecticide storage 14 Abandoned water well 15 Oil well/Gas well 16 Other (specify below)  
 Direction from well? ..... How many feet? .....

FROM	TO	LITHOLOGIC LOG	FROM	TO	PLUGGING INTERVALS
0	6"	Asphalt			
	5'	Silt, very fine sand, gray black, moist, no petroleum odor			
	10'	Trace clay, petroleum odor			
	15'	Sand, very fine to fine, gray black, moist, petroleum odor			
	20'				
	25'	wet, strong petroleum odor			
					Flushmount waiver by D. Taylor

7 CONTRACTOR'S OR LANDOWNER'S CERTIFICATION: This water well was (1) constructed, (2) reconstructed, or (3) plugged under my jurisdiction and was completed on (mo/day/year) 11/15/05 and this record is true to the best of my knowledge and belief. Kansas Water Well Contractor's Licence No. 602 This Water Well Record was completed on (mo/day/yr) 1/28/05 under the business name of Hydrologic by (signature) [Signature]