


1	LOCATION OF WATER WELL:	Fraction	Section Number	Township Number	Range Number
	County: <u>Wyandott</u>	<u>SW 1/4 SW 1/4 N 12 E 4</u>	<u>28</u>	<u>10 S</u>	<u>25 E EW</u>

Distance and direction from nearest town or city street address of well if located within city?  
N. W. corner of Sunshine and Interstate Road

2 WATER WELL OWNER: ~~State of Kansas~~ ←

RR #, St. Address, Box #: ~~609 N 8th St. Topeka~~ Board of Agriculture, Division of Water Resources  
 City, State, ZIP Code: ~~Topeka, Kansas~~ Application Number:

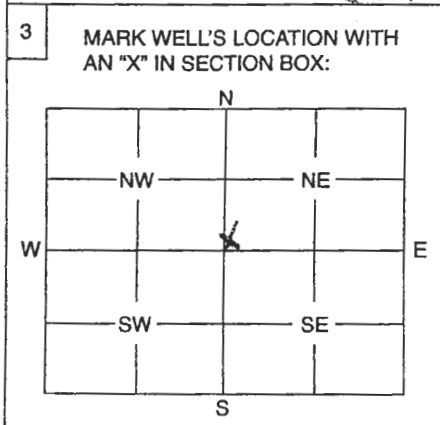

4 DEPTH OF WELL ..... 15.5 ..... ft. CNH America LLC  
 WELL'S STATIC WATER LEVEL ..... 9 ..... ft. (Formerly I I Case Company)  
800 Sunshine Rd.  
Kansas City, KS 66115

WELL WAS USED AS:

1 Domestic	5 Public Water Supply	9 Dewatering
2 Irrigation	6 Oil Field Water Supply	10 Monitoring Well
3 Feedlot	7 Domestic (Lawn & Garden)	11 Injection Well
4 Industrial	8 Air Conditioning	12 Other .....

Was a chemical / bacteriological sample submitted to Department? Yes ..... No X  
 If yes, mo/day/yr sample was submitted .....

Water Well Disinfected: Yes ..... No X

5 TYPE OF BLANK CASING USED:

1 Steel	3 RMP (SR)	5 Wrought	7 Fiberglass	9 Other (Specify below)
<u>2</u> PVC	4 ABS	6 Asbestos-Cement	8 Concrete Tile	

Blank casing diameter 4 in. Was casing pulled? Yes X No ..... If yes, how much .....

Casing height above or below land surface ..... in.

6 GROUT PLUG MATERIAL: 1 Neat cement 2 Cement grout 3 Bentonite 4 Other .....

Grout Plug Intervals: 2 From 2 ft. to 15.5 ft., From ..... ft. to ..... ft., From 2 to ..... ft.

What is the nearest source of possible contamination:

1 Septic tank	6 Seepage pit	<u>11 Fuel storage</u>	16 Other (specify below)
2 Sewer lines	7 Pit privy	12 Fertilizer storage	
3 Watertight sewer lines	8 Sewage lagoon	13 Insecticide storage	
4 Lateral lines	9 Feedyard	14 Abandoned water well	
5 Cess pool	10 Livestock pens	15 Oil well/Gas well	

Direction from well? N How many feet? 10

FROM	TO	PLUGGING MATERIALS
<u>0</u>	<u>2.5</u>	<u>Grout</u>
<u>2</u>	<u>15.5</u>	<u>Grout</u>

Done by W. Ken Co.  
on 3/10/03

RECEIVED  
 FEB 09 2005

7 CONTRACTOR'S OF LANDOWNER'S CERTIFICATION: This water well was plugged under my supervision and was completed on (mo/day/year) 12/2/03 and this record is true to the best of my knowledge and belief. Kansas Water Well Contractor's License No. 65 This Water Well Record was completed on (mo/day/year) ..... under the business name of DFS by (signature) Ken [Signature]

INSTRUCTIONS: Use typewriter or ball point pen. Please press firmly and print clearly. Please fill in blanks, underline or circle the correct answers. Send top three copies to Kansas Department of Health and Environment, Bureau of Water, Geology Section, 1000 SW Jackson