

CORRECTION(S) TO WATER WELL RECORD (WWC-5)
(to rectify lacking or incorrect information)

County: Wyandotte

Location listed as:

Location changed to:

Section-Township-Range: 27-40S-25E

27-10S-25E

Fraction (1/4 1/4 1/4): SW SW

SW SW NW

Other changes: Initial statements: _____

Changed to: _____

Comments: _____

verification method: Well address, city map, and

North Kansas City 1:24,000 topo. map.

initials: DRF date: 3/7/2005


submitted by: Kansas Geological Survey, Data Resources Library, 1930 Constant Ave., Lawrence, KS 66047-3726
to: Kansas Dept of Health & Environment, Bureau of Water, 1000 SW Jackson, Suite 420, Topeka, KS 66612-1367.

1 LOCATION OF WATER WELL: Fraction 1/4 SW 1/4 SW 1/4 Section Number 27 Township Number T40S Range Number R25E E/W

County: WYAN DOTTE

Distance and direction from nearest town or city street address of well if located within city?
3126 BRINKERHOFF RD. ICC ICS 66115

2 WATER WELL OWNER: Jerome E. Cibrik 3200/3300 Kanawha Turnpike
Union Carbide Corp. South Charleston WV 25303
 RR #, St. Address, Box #: PO Box 0361
 City, State, ZIP Code: Board of Agriculture, Division of Water Resources
 Application Number:

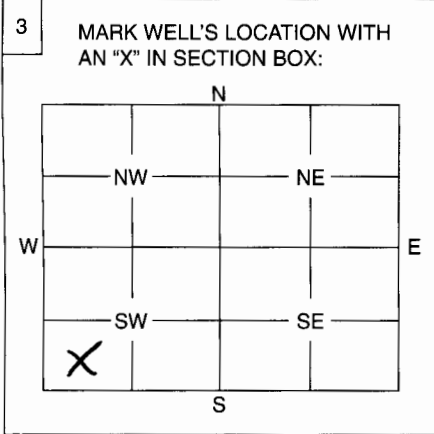

4 DEPTH OF WELL 31 ft.
 WELL'S STATIC WATER LEVEL 22.71 ft.
 WELL WAS USED AS:
 1 Domestic 5 Public Water Supply 9 Dewatering
 2 Irrigation 6 Oil Field Water Supply 10 Monitoring Well
 3 Feedlot 7 Domestic (Lawn & Garden) 11 Injection Well
 4 Industrial 8 Air Conditioning 12 Other Piezometer
 Was a chemical / bacteriological sample submitted to Department? Yes No
 If yes, mo/day/yr sample was submitted
 Water Well Disinfected: Yes No

5 TYPE OF BLANK CASING USED:
 1 Steel 3 RMP (SR) 5 Wrought 7 Fiberglass 9 Other (Specify below)
2 PVC 4 ABS 6 Asbestos-Cement 8 Concrete Tile
 Blank casing diameter 1 in. Was casing pulled? Yes No If yes, how much
 Casing height above or below land surface PUKED in.

6 GROUT PLUG MATERIAL: 1 Neat cement 2 Cement grout 3 Bentonite 4 Other
 Grout Plug Intervals: From 31 ft. to 0 ft., From ft. to ft., From to ft.
 What is the nearest source of possible contamination:
 1 Septic tank 6 Seepage pit 11 Fuel storage 16 Other (Specify below)
 2 Sewer lines 7 Pit privy 12 Fertilizer storage FORMER SOURCE
 3 Watertight sewer lines 8 Sewage lagoon 13 Insecticide storage INSIDE BLDG
 4 Lateral lines 9 Feedyard 14 Abandoned water well (NON EXISTANT)
 5 Cess pool 10 Livestock pens 15 Oil well/Gas well
 Direction from well? SOUTHWEST How many feet? ~ 80'

FROM	TO	PLUGGING MATERIALS
0'	31'	CEMENT GROUT

7 CONTRACTOR'S OF LANDOWNER'S CERTIFICATION: This water well was plugged under my jurisdiction and was completed on (mo/day/year) 1-17-05 and this record is true to the best of my knowledge and belief. Kansas Water Well Contractor's License No. 707 This Water Well Record was completed on (mo/day/year) 1-17-05 under the business name of MAXS
 by (signature) David Hanzell

INSTRUCTIONS: Use typewriter or ball point pen. Please press firmly and print clearly. Please fill in blanks, underline or circle the correct answers. Send top three copies to Kansas Department of Health and Environment, Bureau of Water, Geology Section, 1000 SW Jackson St., Ste. 420, Topeka, Kansas 66612-1367. Telephone: 785/296-5522. Send one to Water Well Owner and retain one for your records.