

CORRECTION(S) TO WATER WELL RECORD (WWC-5)
(to rectify lacking or incorrect information)

County: Wyandotte

Location listed as:

Location changed to:

Section-Township-Range: 28-105-25W

28-105-25E

Fraction (1/4 1/4 1/4): SW NE SW

SW NE SW

Other changes: Initial statements: _____

Changed to: _____

Comments: _____

verification method: Written & legal descriptions, sketch map, and
Parkville 1:24,000 topo. map.

initials: DRL date: 5/19/2005

submitted by: Kansas Geological Survey, Data Resources Library, 1930 Constant Ave., Lawrence, KS 66047-3726
to: Kansas Dept of Health & Environment, Bureau of Water, 1000 SW Jackson, Suite 420, Topeka, KS 66612-1367.

USE TYPEWRITER OR BALL POINT PEN-PRESS FIRMLY, PRINT CLEARLY.


T R EW sec 1/4 1/4 1/4 No.

WATER WELL RECORD
KSA 82a-1201-1215

Kansas State Dept. Of Health
(Water Well Contractors)
Forbes-Bldg. 740
Topeka, Kansas 66620

1 Location of well: County WYANDOTTE Township name SW 1/4 Section number 28 Town number 10 S. Range number 35 W.

Distance and direction from nearest town or city: IN K.C. KS. 3 Owner of well: GARNEY CONST. CO.
Street address of well location if in city: B.P.U. - QUINDARO DISTRICT Address: 1331 N.W. VIVION RD, K.C. MO.

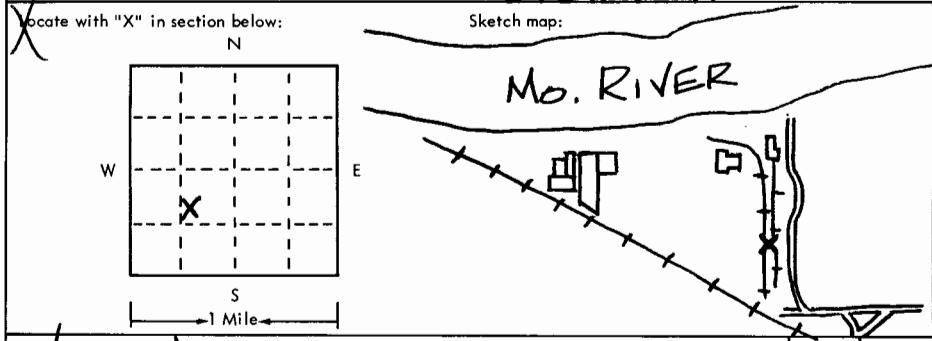

4 Well depth: 84.25 ft. Date of completion 3/10/76
Well diameter 26 in.

5 Cable tool Rotary Driven Dug
 Hollow rod Jetted Bored Reverse rotary

6 Use: Domestic Public supply Industry
 Irrigation Air conditioning Commercial
 Test well DEWATERING

7 Casing: Material STEEL Height: above/below
Threaded Welded Surface 24 in.
Diam. 12 in. to 64 ft. depth Drive shoe? Yes No
Weight 29.1 lbs./ft. 12 in. to 64 ft. depth

2 WELL No. 5	Type and color of material	From	To
	TOPSOIL	0	2'
	BLUE CLAY	2'	21'
	GRAY FINE SAND WITH CLAY BALLS	21'	33'
	VERY FINE SAND WITH CLAY BALLS	33'	38'
	FINE SAND	38'	43'
	FINE TO MEDIUM SAND	43'	44'
	VERY FINE SAND	44'	73'
	MEDIUM TO COARSE SAND	73'	84'

8 Screen: Manufacturer DOERR
Type SLOTTED Dia. 12"
Slot/gauze 7 GA. Length 20'
Set between 64 ft. and 84 ft.
Fittings: Gravel pack Yes No Size range of material 1/4"

9 Static water level: 21.5 ft. below land surface Date 3/10/76
 Pumping level below land surfaces:
65 ft. after 160 hrs. pumping 450 g.p.m.
____ ft. after ____ hrs. pumping ____ g.p.m.
Estimated maximum yield ____ g.p.m.

11 Water sample submitted:
 Yes No Date ____

12 Well head completion:
 Pitless adapter Inches above grade
 Well grouted? Yes No NATURAL
 Neat cement Bentonite BACKFILL
Depth: From 0 ft. to 84 ft.

14 Nearest source of possible contamination:
ft. 100 Direction WEST Type COAL PILE
Well disinfected upon completion? Yes No

15 Pump: Not installed
Manufacturer's name _____
Model number _____ HP _____ Volts _____
Length of drop pipe _____ ft. capacity _____ g.p.m.
Type:
 Submersible Turbine
 Jet Reciprocating
 Centrifugal Other

16 Remarks: elevation APPROX. 800' 750' PM

Topography:
 Hill
 Slope
 Upland
 Valley

17 Water well contractor's certification:
This well was drilled under my jurisdiction and this report is true to the best of my knowledge and belief.
LAYNE-WESTERN CO. 149
Business name _____ License No. _____
Address 1910 W. 30th ST. - K.C. MO.
Signed W. P. [Signature] Date 10/2/76
Authorized representative

10 2500 28 SW NESW