

CORRECTION(S) TO WATER WELL RECORD (WWC-5)
(to rectify lacking or incorrect information)

County: Wyandotte

Location listed as:

Location changed to:

Section-Township-Range: 27-10S-33W

27-10S-25E

Fraction ($\frac{1}{4}$ $\frac{1}{4}$ $\frac{1}{4}$): NE NW NE

NE NW NE

Other changes: Initial statements: _____

Changed to: _____

Comments: _____

verification method: Well address, city street map, position on plat map, and North Kansas City 1:24,000 topo. map.

initials: ARL date: 5/20/2005


submitted by: Kansas Geological Survey, Data Resources Library, 1930 Constant Ave., Lawrence, KS 66047-3726
to: Kansas Dept of Health & Environment, Bureau of Water, 1000 SW Jackson, Suite 420, Topeka, KS 66612-1367.

1 LOCATION OF WATER WELL: County: Wyandotte	Fraction NE 1/4 NW 1/4 NE 1/4	Section Number 27	Township Number T 10 S	Range Number R 33 E/W
--	----------------------------------	----------------------	---------------------------	--------------------------

Distance and direction from nearest town or city street address of well if located within city?
 100 Kindelberger Road, Kansas City, Kansas

2 WATER WELL OWNER: GM Corporation
 RR#, St. Address, Box # : 100 Kindelberger Road Board of Agriculture, Division of Water Resources
 City, State, ZIP Code : Kansas City, Kansas 66115 Application Number:

3 LOCATE WELL'S LOCATION WITH AN "X" IN SECTION BOX:
 4 DEPTH OF COMPLETED WELL... 88.6... ft. ELEVATION:

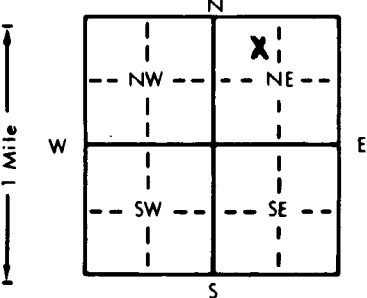

Depth(s) Groundwater Encountered 1. 17 ft. 2. ft. 3. ft.
 WELL'S STATIC WATER LEVEL... 17... ft. below land surface measured on mo/day/yr... 12/14/84
 Pump test data: Well water was 26 ft. after 4 hours pumping 2,000 gpm
 Est. Yield 2,500 gpm: Well water was ft. after hours pumping gpm
 Bore Hole Diameter... 30 in. to 88.6 ft., and in. to ft.
 WELL WATER TO BE USED AS:
 1 Domestic 3 Feedlot 5 Public water supply 8 Air conditioning 11 Injection well
 2 Irrigation 4 Industrial 6 Oil field water supply 9 Dewatering 12 Other (Specify below)
 7 Lawn and garden only 10 Observation well
 Was a chemical/bacteriological sample submitted to Department? Yes No X; If yes, mo/day/yr sample was submitted
 Water Well Disinfected? Yes X No

5 TYPE OF BLANK CASING USED:
 Steel 3 RMP (SR) 5 Wrought iron 8 Concrete tile CASING JOINTS: Glued Clamped
 PVC 4 ABS 6 Asbestos-Cement 9 Other (specify below) Welded X
 Fiberglass Threaded

Blank casing diameter... 16 in. to 48.6 ft., Dia... in. to ft., Dia... in. to ft.
 Casing height above land surface... 8 in., weight... 62.58 lbs./ft. Wall thickness or gauge No. 375

TYPE OF SCREEN OR PERFORATION MATERIAL:
 Steel 3 Stainless steel 5 Fiberglass 7 PVC 10 Asbestos-cement
 Brass 4 Galvanized steel 6 Concrete tile 8 RMP (SR) 11 Other (specify)
 None used (open hole)

SCREEN OR PERFORATION OPENINGS ARE:
 Continuous slot Mill slot 5 Gauzed wrapped 8 Saw cut 11 None (open hole)
 Louvered shutter 4 Key punched 6 Wire wrapped 9 Drilled holes
 Torch cut 10 Other (specify)

SCREEN-PERFORATED INTERVALS: From 48.6 ft. to 88.6 ft., From ft. to ft.
 GRAVEL PACK INTERVALS: From 20 ft. to 88.6 ft., From ft. to ft.

6 GROUT MATERIAL: 1 Neat cement 2 Cement grout Bentonite 4 Other
 Grout intervals: From 0 ft. to 20 ft., From ft. to ft., From ft. to ft.

What is the nearest source of possible contamination:
 Septic tank Lateral lines 7 Pit privy 10 Livestock pens 14 Abandoned water well
 Sewer lines 5 Cess pool 8 Sewage lagoon 11 Fuel storage 15 Oil well/Gas well
 Watertight sewer lines 6 Seepage pit 9 Feedyard 12 Fertilizer storage 16 Other (specify below)
 Insecticide storage
 Direction from well? all around How many feet? 20

FROM	TO	LITHOLOGIC LOG	FROM	TO	LITHOLOGIC LOG
0.0	0.7	Cement			
0.7	2.0	Topsoil			
2.0	10.0	Silty clay			
10.0	25.0	Silty sandy clay			
25.0	30.0	Fine to very fine sand & Middle			
30.0	35.0	Fine to very fine sandy clay balls			
35.0	40.0	Fine to very fine sand, trace med.			
40.0	58.0	Fine to very fine sand, trace med.			
58.0	75.0	Med. to coarse sand & boulders			
75.0	86.0	Med. sand & gravel & rough boulders			
86.0	Total	Depth			

7 CONTRACTOR'S OR LANDOWNER'S CERTIFICATION: This water well was constructed, (2) reconstructed, or (3) plugged under my jurisdiction and was completed on (mo/day/year) 12/14/84 and this record is true to the best of my knowledge and belief. Kansas Water Well Contractor's License No. 102 This Water Well Record was completed on (mo/day/year) 12/14/84 under the business name of Layne-Western Company, Inc. by (signature) D.D. Smith

INSTRUCTIONS: Use typewriter or ball point pen. PLEASE PRESS FIRMLY and PRINT clearly. Please fill in blanks, underline or circle the correct answers. Send top three copies to Kansas Department of Health and Environment, Division of Environment, Environmental Geology Section, Topeka, KS 66620. Send one to WATER WELL OWNER and retain one for your records.

OFFICE USE ONLY
T
R
EW
SEC
1/4
1/4
1/4