

CORRECTION(S) TO WATER WELL RECORD (WWC-5)

(to rectify lacking or incorrect information)

County: Wyandotte

Location listed as:

Section-Township-Range: 34-105-33W

Fraction (1/4 1/4 1/4): SE NE SE

Location changed to:

34-105-25E

SE NE SE

Other changes: Initial statements: _____

Changed to: _____

Comments: _____

verification method: Written & legal descriptions, city map, position on plat map, and North Kansas City 1:24,000 topo. map.

initials: DR date: 5/20/2005

submitted by: Kansas Geological Survey, Data Resources Library, 1930 Constant Ave., Lawrence, KS 66047-3726

to: Kansas Dept of Health & Environment, Bureau of Water, 1000 SW Jackson, Suite 420, Topeka, KS 66612-1367.

CORRECTION(S) TO WATER WELL RECORD (WWC-5)

(to rectify lacking or incorrect information)

County: Wyandotte

Location listed as:

Section-Township-Range: 34-105-33W

Fraction (1/4 1/4 1/4): SE NE SE

Location changed to:

34-105-25E

SE NE SE

Other changes: Initial statements: _____

Changed to: _____

Comments: _____

verification method: Written & legal descriptions, city map, position on plat map, and North Kansas City 1:24,000 topo. map.


initials: DR date: 5/20/2005

submitted by: Kansas Geological Survey, Data Resources Library, 1930 Constant Ave., Lawrence, KS 66047-3726
to: Kansas Dept of Health & Environment, Bureau of Water, 1000 SW Jackson, Suite 420, Topeka, KS 66612-1367.

1] LOCATION OF WATER WELL:	Fraction	Section Number	Township Number	Range Number
County: Wyandotte	SE 1/4 NE 1/4 SE 1/4	34	T 10 S	R 33 EW

Distance and direction from nearest town or city street address of well if located within city?
Donovan & Industrial Blvd.; Kansas City, Kansas

2] WATER WELL OWNER: Phillips Petroleum
 RR#, St. Address, Box #: P.O. Box 15036
 City, State, ZIP Code: Kansas City, Kansas 66115
 Board of Agriculture, Division of Water Resources
 Application Number:

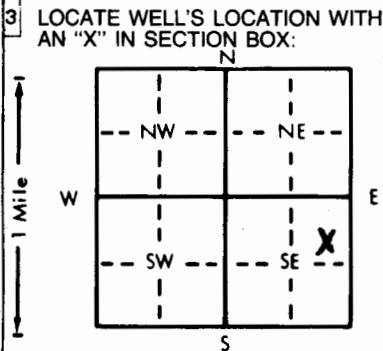

4] DEPTH OF COMPLETED WELL: 57.7 ft. ELEVATION: 741
 Depth(s) Groundwater Encountered 1. 12 ft. 2. _____ ft. 3. _____ ft.
 WELL'S STATIC WATER LEVEL 14.3 ft. below land surface measured on mo/day/yr 8-15-84
 Pump test data: Well water was 28.8 ft. after 2 hours pumping 821 gpm
 Est. Yield 500 gpm: Well water was _____ ft. after _____ hours pumping _____ gpm
 Bore Hole Diameter .36 in. to 57.7 ft., and _____ in. to _____ ft.
 WELL WATER TO BE USED AS:
 5 Public water supply 8 Air conditioning 11 Injection well
 1 Domestic 3 Feedlot 6 Oil field water supply 9 Dewatering 12 Other (Specify below)
 2 Irrigation 4 Industrial 7 Lawn and garden only 10 Observation well
 Was a chemical/bacteriological sample submitted to Department? Yes _____ No X; If yes, mo/day/yr sample was submitted _____
 Water Well Disinfected? Yes X No

5] TYPE OF BLANK CASING USED:
 1 Steel 3 RMP (SR) 5 Wrought iron 8 Concrete tile CASING JOINTS: Glued _____ Clamped _____
 2 PVC 4 ABS 6 Asbestos-Cement 9 Other (specify below) Welded X
 7 Fiberglass Threaded _____
 Blank casing diameter 20 in. to 37.7 ft., Dia _____ in. to _____ ft., Dia _____ in. to _____ ft.
 Casing height above land surface 52 in., weight 78.60 lbs./ft. Wall thickness or gauge No. 375
 TYPE OF SCREEN OR PERFORATION MATERIAL:
 1 Steel 3 Stainless steel 5 Fiberglass 7 PVC 10 Asbestos-cement
 2 Brass 4 Galvanized steel 6 Concrete tile 8 RMP (SR) 11 Other (specify) _____
 9 ABS 12 None used (open hole)
 SCREEN OR PERFORATION OPENINGS ARE:
 1 Continuous slot 3 Mill slot 5 Gauzed wrapped 8 Saw cut 11 None (open hole)
 2 Louvered shutter 4 Key punched 6 Wire wrapped 9 Drilled holes
 7 Torch cut 10 Other (specify) _____
 SCREEN-PERFORATED INTERVALS: From 37.7 ft. to 57.7 ft., From _____ ft. to _____ ft.
 From _____ ft. to _____ ft., From _____ ft. to _____ ft.
 GRAVEL PACK INTERVALS: From 14 ft. to 57.7 ft., From _____ ft. to _____ ft.
 From _____ ft. to _____ ft., From _____ ft. to _____ ft.

6] GROUT MATERIAL: 1 Neat cement 2 Cement grout 3 Bentonite 4 Other _____
 Grout Intervals: From 0 ft. to 14 ft., From _____ ft. to _____ ft., From _____ ft. to _____ ft.
 What is the nearest source of possible contamination:
 1 Septic tank 4 Lateral lines 7 Pit privy 10 Livestock pens 14 Abandoned water well
 2 Sewer lines 5 Cess pool 8 Sewage lagoon 11 Fuel storage 15 Oil well/Gas well
 3 Watertight sewer lines 6 Seepage pit 9 Feedyard 12 Fertilizer storage 16 Other (specify below)
 13 Insecticide storage
 Direction from well? all around How many feet? 25

FROM	TO	LITHOLOGIC LOG	FROM	TO	LITHOLOGIC LOG
0.0	1.0	Gravel (fill)	38.5	40.0	Gray fine to med. sand, trace v. fin
1.0	11.0	Gray clay silt, very soft	40.0	41.5	XXXX Same
11.0	15.0	Gray fine to very fine sand	41.5	45.0	Same
15.0	16.5	Same	45.0	46.5	Same
16.5	18.0	Same	46.5	48.5	Same
18.0	20.0	Gray fine to very fine sand	48.5	50.0	Gray med. sand, trace boulders
20.0	21.5	Same	50.0	51.5	Same
21.5	25.0	Gray fine to very fine sand, lignite	51.5	54.0	Same
25.0	26.5	Gray fine to very fine sand, med.	54.0	59.0	Gray coarse to med. sand, boulders
26.5	27.5	Same	59.0	59.5	Limestone, hard
27.5	30.0	Gray fine to very fine sand	59.5	Total	Depth
30.0	31.5	Same			
31.5	35.0	Same			
35.0	36.5	Same			
36.5	38.5	Same			

7] CONTRACTOR'S OR LANDOWNER'S CERTIFICATION: This water well was 1 constructed, (2) reconstructed, or (3) plugged under my jurisdiction and was completed on (mo/day/year) 8/15/84 and this record is true to the best of my knowledge and belief. Kansas Water Well Contractor's License No. 102 This Water Well Record was completed on (mo/day/yr) 11/15/84 under the business name of Layne-Western Company, Inc. by (signature) [Signature]

INSTRUCTIONS: Use typewriter or ball point pen, PLEASE PRESS FIRMLY and PRINT clearly. Please fill in blanks, underline or circle the correct answers. Send top three copies to Kansas Department of Health and Environment, Division of Environment, Environmental Geology Section, Topeka, KS 66620. Send one to WATER WELL OWNER and retain one for your records.