

CORRECTION(S) TO WATER WELL RECORD (WWC-5)
(to rectify lacking or incorrect information)

County: Wyandotte

Location listed as:

Section-Township-Range: 34-105-33W

Fraction ($\frac{1}{4}$ $\frac{1}{4}$ $\frac{1}{4}$): NW SE SE

Location changed to:

34-105-25E

NW SE SE

Other changes: Initial statements: _____

Changed to: _____

Comments: _____

verification method: Written & legal descriptions, city map, position on plat map, and North Kansas City 1:24,000 topo. map.

initials: DR date: 5/20/2005


submitted by: Kansas Geological Survey, Data Resources Library, 1930 Constant Ave., Lawrence, KS 66047-3726
to: Kansas Dept of Health & Environment, Bureau of Water, 1000 SW Jackson, Suite 420, Topeka, KS 66612-1367.

1 LOCATION OF WATER WELL: County: **Wyandotte** Fraction: **NW 1/4 SE 1/4 SE 1/4** Section Number: **34** Township Number: **T 10 S** Range Number: **R 33 E/W**

Distance and direction from nearest town or city street address of well if located within city?
Donovan & Industrial Blvd.; Kansas City, Kansas

2 WATER WELL OWNER: **Phillips Petroleum**
 RR#, St. Address, Box # : **P.O. Box 15036** Board of Agriculture, Division of Water Resources
 City, State, ZIP Code : **Kansas City, Kansas 66115** Application Number:

3 LOCATE WELL'S LOCATION WITH AN "X" IN SECTION BOX: 4 DEPTH OF COMPLETED WELL: **38** ft. ELEVATION: **741**

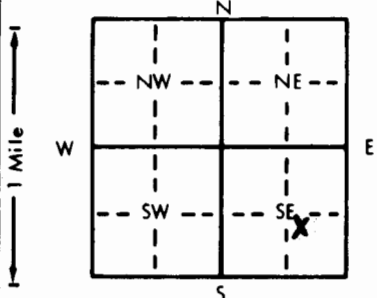

Depth(s) Groundwater Encountered 1. **10** ft. 2. ft. 3. ft.
 WELL'S STATIC WATER LEVEL **14** ft. below land surface measured on mo/day/yr **9-2-84**
 Pump test data: Well water was **--** ft. after **--** hours pumping **--** gpm
 Est. Yield **--** gpm: Well water was **--** ft. after **--** hours pumping **--** gpm
 Bore Hole Diameter **24** in. to **38** ft., and **--** in. to **--** ft.
 WELL WATER TO BE USED AS: 5 Public water supply 8 Air conditioning 11 Injection well
 1 Domestic 3 Feedlot 6 Oil field water supply 9 Dewatering **12** Other (Specify below)
 2 Irrigation 4 Industrial 7 Lawn and garden only 10 Observation well **Oil Recovery**
 Was a chemical/bacteriological sample submitted to Department? Yes **X** No **--**; If yes, mo/day/yr sample was submitted
 Water Well Disinfected? Yes **X** No **--**

5 TYPE OF BLANK CASING USED: 5 Wrought iron 8 Concrete tile CASING JOINTS: Glued **--** Clamped **--**
 1 Steel 3 RMP (SR) 6 Asbestos-Cement 9 Other (specify below) Welded **X**
 2 PVC 4 ABS 7 Fiberglass Threaded **--**

Blank casing diameter **8** in. to **13** ft., Dia **--** in. to **--** ft., Dia **--** in. to **--** ft.
 Casing height above land surface **36** in., weight **28.55** lbs./ft. Wall thickness or gauge No. **322**

TYPE OF SCREEN OR PERFORATION MATERIAL: 7 PVC 10 Asbestos-cement
 1 Steel 3 Stainless steel 5 Fiberglass 8 RMP (SR) 11 Other (specify) **--**
 2 Brass 4 Galvanized steel 6 Concrete tile 9 ABS 12 None used (open hole)

SCREEN OR PERFORATION OPENINGS ARE: 5 Gauzed wrapped 8 Saw cut 11 None (open hole)
 1 Continuous slot 3 Mill slot 6 Wire wrapped 9 Drilled holes
 2 Louvered shutter 4 Key punched 7 Torch cut 10 Other (specify) **--**

SCREEN-PERFORATED INTERVALS: From **13** ft. to **38** ft., From **--** ft. to **--** ft.
 From **--** ft. to **--** ft., From **--** ft. to **--** ft.
 GRAVEL PACK INTERVALS: From **11** ft. to **38** ft., From **--** ft. to **--** ft.
 From **--** ft. to **--** ft., From **--** ft. to **--** ft.

6 GROUT MATERIAL: 1 Neat cement 2 Cement grout 3 Bentonite 4 Other **--**
 Grout Intervals: From **0** ft. to **11** ft., From **--** ft. to **--** ft., From **--** ft. to **--** ft.

What is the nearest source of possible contamination:
 1 Septic tank 4 Lateral lines 7 Pit privy 10 Livestock pens 14 Abandoned water well
 2 Sewer lines 5 Cess pool 8 Sewage lagoon 11 Fuel storage 15 Oil well/Gas well
 3 Watertight sewer lines 6 Seepage pit 9 Feedyard 12 Fertilizer storage 16 Other (specify below)
 13 Insecticide storage
 Direction from well? **all around** How many feet? **25**

FROM	TO	LITHOLOGIC LOG	FROM	TO	LITHOLOGIC LOG
0.0	12.0	Gravel, clay, very soft (fill)			
12.0	15.0	Gray very fine to fine sand			
15.0	16.5	Same			
16.5	20.0	Same			
20.0	21.5	Same			
21.5	23.0	Same			
23.0	25.0	Gray fine to very fine sand			
25.0	26.5	Same			
26.5	30.0	Same			
30.0	31.5	Same			
31.5	35.0	Same			
35.0	36.5	Same			
36.5	38.0	Same			
38.0	Total	Depth			

7 CONTRACTOR'S OR LANDOWNER'S CERTIFICATION: This water well was **1** constructed, (2) reconstructed, or (3) plugged under my jurisdiction and was completed on (mo/day/year) **11/15/84** **9/2/84** and this record is true to the best of my knowledge and belief. Kansas Water Well Contractor's License No. **102** This Water Well Record was completed on (mo/day/yr) **11/15/84** under the business name of **Layne-Western Company, Inc.** by (signature) **D.D. Smith**

INSTRUCTIONS: Use typewriter or ball point pen, PLEASE PRESS FIRMLY and PRINT clearly. Please fill in blanks, underline or circle the correct answers. Send top three copies to Kansas Department of Health and Environment, Division of Environment, Environmental Geology Section, Topeka, KS 66620. Send one to WATER WELL OWNER and retain one for your records.

OFFICE USE ONLY
 T 10
 R 33
 SEC. 34
 NW 1/4 SE 1/4