WATER WELL RECORD Form WWC-5 KSA 82a-1212 ID No. _____

1 LOCATION OF WATER WELL: County: Wyandotte	Fraction: NE ¼ NW ¼ SW ¼	Section Number: 27	Township Number: T 10 S	Range Number: R 25 (E)/W

Distance and direction from nearest town or city street address of well if located within city?
401 Kindleberger Road Kansas City KS 66115

2 WATER WELL OWNER: International Papers
RR#, St. Address, Box # : 3 Paragon Drive
City, State, ZIP Code : Montvale NJ 07646

Board of Agriculture, Division of Water Resources Application Number:

3 LOCATE WELL'S LOCATION WITH AN "X" IN SECTION BOX:

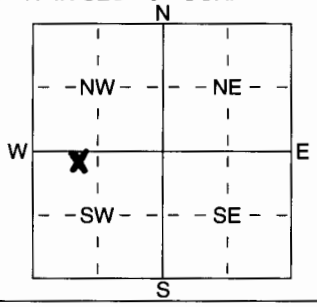

4 DEPTH OF COMPLETED WELL 30 ft. ELEVATION:
Depth(s) Groundwater Encountered 1 ft. 2 — ft. 3 — ft.
WELL'S STATIC WATER LEVEL 23 ft. below land surface measured on mo/day/yr 6.02.05
Pump test data: Well water was — ft. after — hours pumping — gpm
Est. Yield — gpm: Well water was — ft. after — hours pumping — gpm
WELL WATER TO BE USED AS: 5 Public water supply 8 Air conditioning 11 Injection well
1 Domestic 3 Feedlot 6 Oil field water supply 9 Dewatering 12 Other (Specify below)
2 Irrigation 4 Industrial 7 Domestic (lawn & garden) (10) Monitoring well MP-3

Was a chemical/bacteriological sample submitted to Department? Yes ..... No X; If yes, mo/day/yrs sample was submitted
Water Well Disinfected? Yes No X

5 TYPE OF BLANK CASING USED:
1 Steel 3 RMP (SR) 5 Wrought iron 8 Concrete tile
(2) PVC 4 ABS 6 Asbestos-Cement 9 Other (specify below)
7 Fiberglass

CASING JOINTS: Glued ..... Clamped ..... Welded ..... Threaded X

Blank casing diameter 1 in. to 15 ft., Dia ..... in. to ..... ft., Dia ..... in. to ..... ft.
Casing height above land surface Flushmount in., weight Sch 40 lbs./ft. Wall thickness or guage No. .....
TYPE OF SCREEN OR PERFORATION MATERIAL:
1 Steel 3 Stainless Steel 5 Fiberglass (7) PVC 10 Asbestos-Cement
2 Brass 4 Galvanized Steel 6 Concrete tile 8 RMP (SR) 11 Other (Specify) .....
9 ABS 12 None used (open hole)

SCREEN OR PERFORATION OPENINGS ARE:
1 Continuous slot (3) Mill slot 5 Guazed wrapped 8 Saw cut 11 None (open hole)
2 Louvered shutter 4 Key punched 6 Wire wrapped 9 Drilled holes
7 Torch cut 10 Other (specify) ..... ft.

SCREEN-PERFORATED INTERVALS: From 15 ft. to 30 ft., From ..... ft. to ..... ft.
From ..... ft. to ..... ft., From ..... ft. to ..... ft.
GRAVEL PACK INTERVALS: From 13 ft. to 30 ft., From ..... ft. to ..... ft.
From ..... ft. to ..... ft., From ..... ft. to ..... ft.

6 GROUT MATERIAL: 1 Neat cement 2 Cement grout (3) Bentonite 4 Other .....
Grout Intervals: From 2 ft. to 13 ft., From ..... ft. to ..... ft., From ..... ft. to ..... ft.
What is the nearest source of possible contamination:
1 Septic tank 4 Lateral lines 7 Pit privy 10 Livestock pens 14 Abandoned water well
2 Sewer lines 5 Cess pool 8 Sewage lagoon 11 Fuel storage 15 Oil well/Gas well
3 Watertight sewer lines 6 Seepage pit 9 Feedyard 12 Fertilizer storage (16) Other (specify below) Contaminated Site
13 Insecticide storage
Direction from well? How many feet?

FROM	TO	LITHOLOGIC LOG	FROM	TO	PLUGGING INTERVALS
0	.4	Asphalt			
.4	3	Lean clay fill			
3	5	Poorly sorted gravel			
5	12	Silty lean clay			
12	30	sand well sorted			

7 CONTRACTOR'S OR LANDOWNER'S CERTIFICATION: This water well was (1) constructed, (2) reconstructed, or (3) plugged under my jurisdiction and was completed on (mo/day/year) 5.17.05 and this record is true to the best of my knowledge and belief. Kansas Water Well Contractor's Licence No 710 This Water Well Record was completed on (mo/day/yr) 5.20.05 under the business name of Below Ground Surface Inc by (signature) [signature]

INSTRUCTIONS: Use typewriter or ball point pen. *PLEASE PRESS FIRMLY* and *PRINT* clearly. Please fill in blanks, underline or circle the correct answers. Send top three copies to Kansas Department of Health and Environment, Bureau of Water, Geology Section, 1000 SW Jackson St., Suite 420, Topeka, Kansas 66612-1367. Telephone 785-296-5522. Send one to WATER WELL OWNER and retain one for your records. Fee of $5.00 for each constructed well.