

CORRECTION(S) TO WATER WELL RECORD (WWC-5)

(to rectify lacking or incorrect information)

County: Wyandotte

Location listed as:

Section-Township-Range: 22-50N-33W

Fraction (  $\frac{1}{4}$   $\frac{1}{4}$   $\frac{1}{4}$ ): E  $\frac{1}{2}$  NE NE

Location changed to:

34-105-25E

NW NE SE SE

Other changes: Initial statements: \_\_\_\_\_

Changed to: \_\_\_\_\_

Comments: \_\_\_\_\_

verification method: Map of well locations from owner, and  
North Kansas City 1:24,000 topo. map.

initials: ORA date: 9/8/2005

submitted by: Kansas Geological Survey, Data Resources Library, 1930 Constant Ave., Lawrence, KS 66047-3726  
to: Kansas Dept of Health & Environment, Bureau of Water, 1000 SW Jackson, Suite 420, Topeka, KS 66612-1367.





<b>PROJECT NUMBER</b> 321564.SI.01	<b>BORING NUMBER</b> PZ-444	SHEET 1 OF 1
---------------------------------------	--------------------------------	--------------

## SOIL BORING LOG

<b>PROJECT :</b> Conoco Phillips - Supplemental SI	<b>NORTHING:</b> 308842.29	<b>EASTING:</b> 2274998.83
<b>ELEVATION :</b> 746.56 ft b.t.o.c.	<b>DRILLING CONTRACTOR :</b> Max's Enterprises Inc.	
<b>DRILLING METHOD AND EQUIPMENT USED</b> Mobile B-53	<b>LOGGER :</b> E. Molander	
<b>WATER LEVELS :</b> 22' bgs	<b>START :</b> 11/05/04 1250	<b>END :</b> 11/05/04

DEPTH BELOW SURFACE (FT)	INTERVAL (FT)		STANDARD PENETRATION TEST RESULTS 6"-6"-6" (N)	SOIL DESCRIPTION SOIL NAME, USCS GROUP SYMBOL, COLOR, MOISTURE CONTENT, RELATIVE DENSITY, OR CONSISTENCY, SOIL STRUCTURE, MINERALOGY.	COMMENTS DEPTH OF CASING, DRILLING RATE, DRILLING FLUID LOSS, TESTS, AND INSTRUMENTATION.  Notes
	RECOVERY (FT)	#/TYPE			
				0.0': Sandy, silty, clayey fill with trace gravel, brown to gray, moist, well graded	
				4.0': Silty clay (CL), dark gray, moist, stiff to firm, slight irredescence, slight odor	
				8.0': Silty clay (CL), gray to dark gray, moist, soft, slight irredescence, odor	
				11.0': Sandy silt (ML), brown, moist, strong odor	
				14.0': Poorly graded sand (SP), brown, moist, fine to medium, strong odor	
				18.0': Grades very moist	
				22.0': Poorly graded sand (SP), dark gray to gray, wet, medium, very strong odor, encounter water	
				35.0': End of boring	

R 25 E

NE

NW

34

35

SE

SW

T 10 S

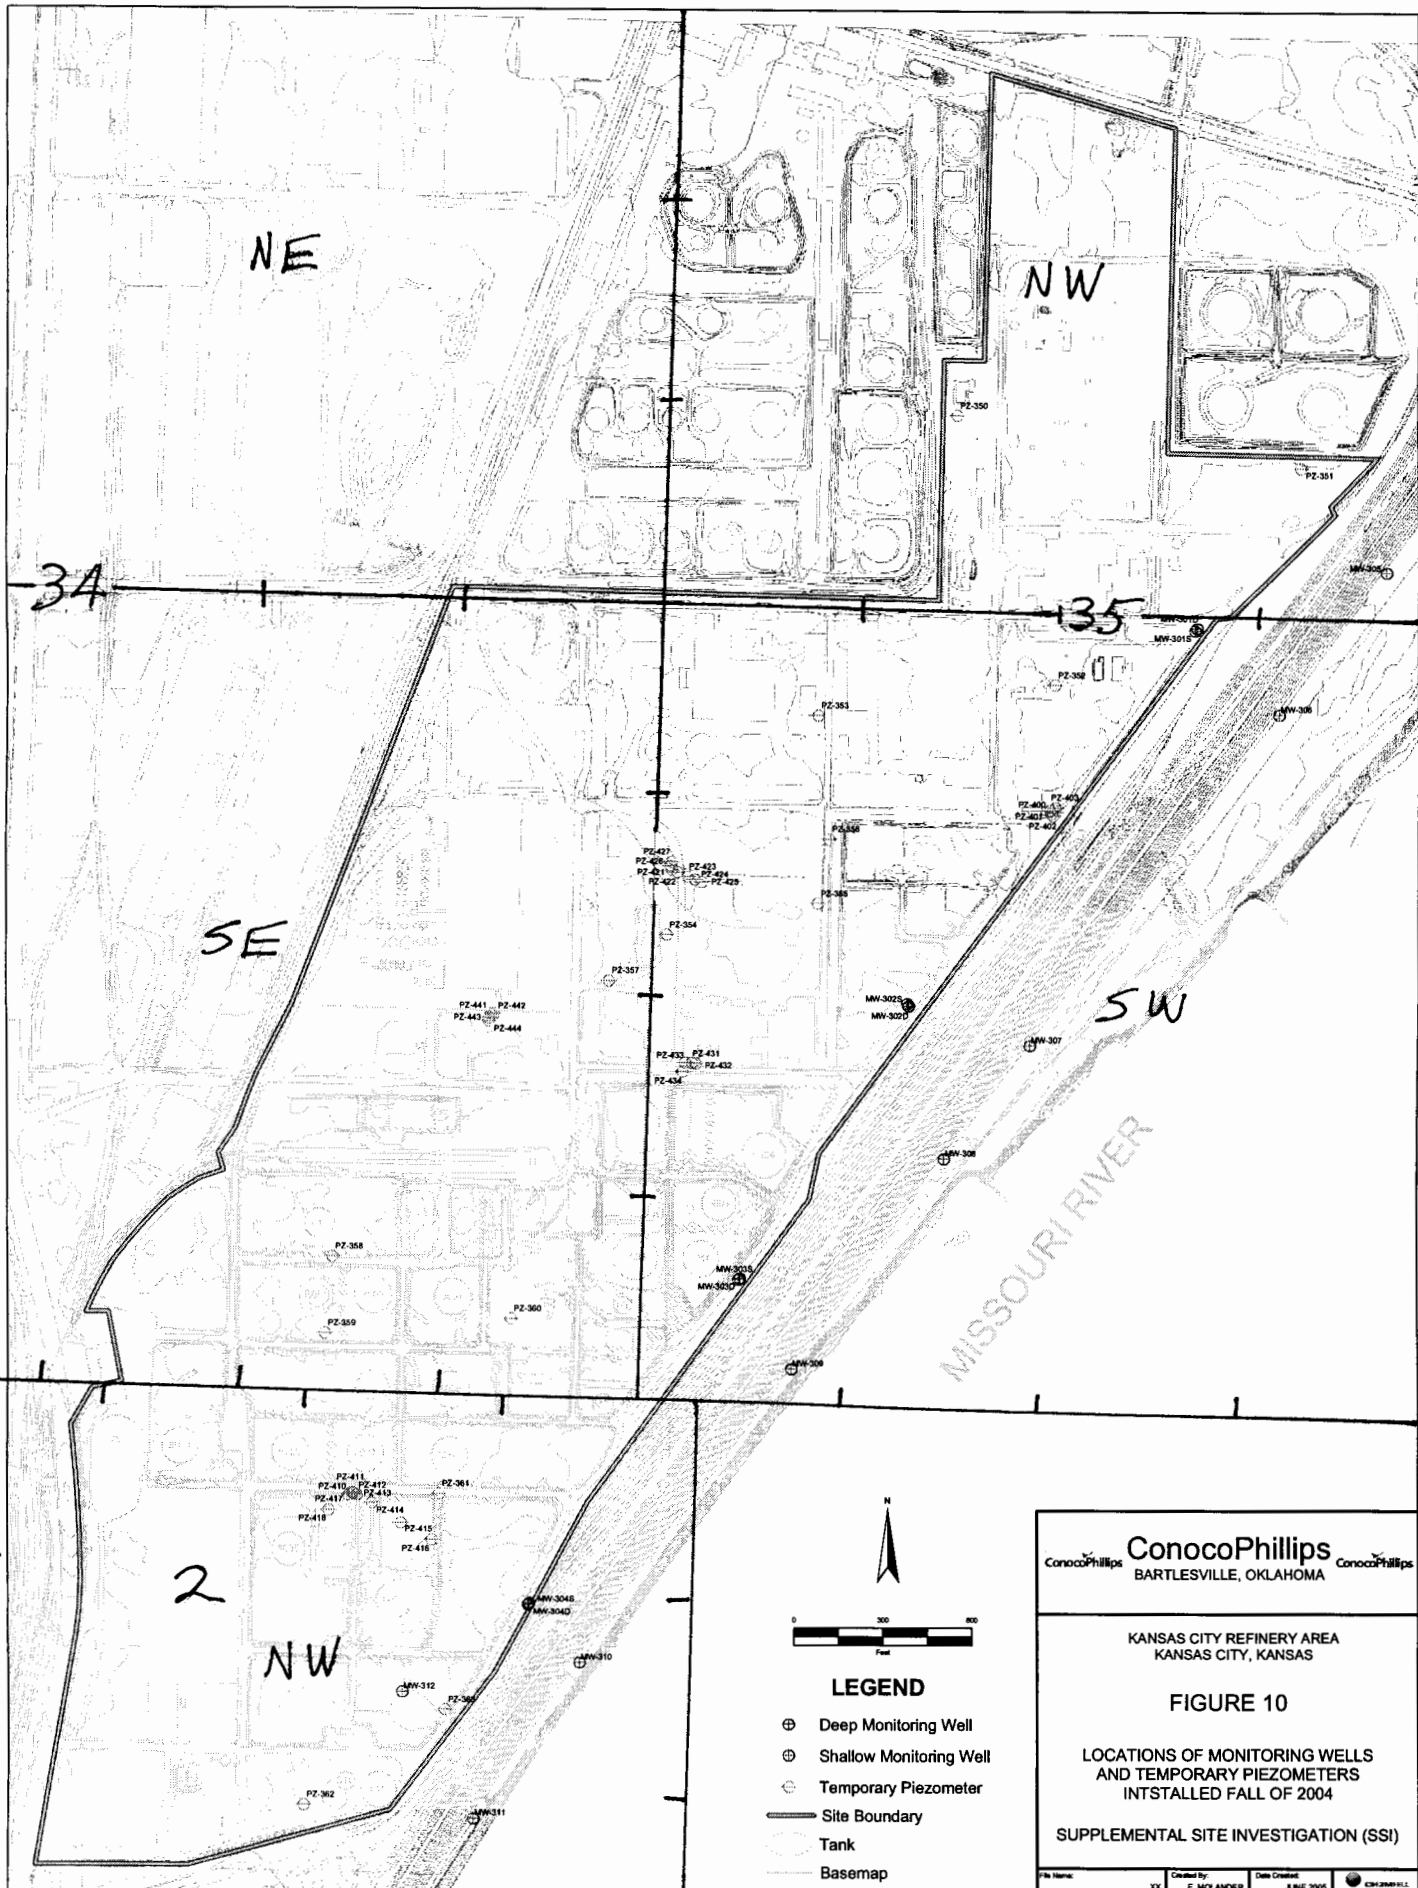
T 11 S



2

NW

N. KC  
KC

MISSOURI RIVER




**ConocoPhillips**
  
 BARTLESVILLE, OKLAHOMA

---

KANSAS CITY REFINERY AREA  
 KANSAS CITY, KANSAS

**FIGURE 10**  
 LOCATIONS OF MONITORING WELLS  
 AND TEMPORARY PIEZOMETERS  
 INSTALLED FALL OF 2004

SUPPLEMENTAL SITE INVESTIGATION (SSI)

---

File Name: XX Created By: E. MCLANDER Date Created: JUNE 2005