

CORRECTION(S) TO WATER WELL RECORD (WWC-5)

(to rectify lacking or incorrect information)

County: Wyandotte

Location listed as:

Section-Township-Range: 30-105-25E

Fraction ($\frac{1}{4}$ $\frac{1}{4}$ $\frac{1}{4}$): E $\frac{1}{2}$ SE SW

Location changed to:

34-105-25E

S2 SW SE SE

Other changes: Initial statements: _____

Changed to: _____

Comments: _____

verification method: Map of well locations from owner, and
North Kansas City 1:24,000 topo. map

initials: DRd date: 9/9/2005

submitted by: Kansas Geological Survey, Data Resources Library, 1930 Constant Ave., Lawrence, KS 66047-3726
to: Kansas Dept of Health & Environment, Bureau of Water, 1000 SW Jackson, Suite 420, Topeka, KS 66612-1367.



PROJECT NUMBER 321564.SI.01	BORING NUMBER PZ-359
SHEET 1 OF 1	
SOIL BORING LOG	

PROJECT : Conoco Phillips - Supplemental SI	NORTHING: 307771.50	EASTING: 2274508.77
ELEVATION : 742.19 ft b.t.o.c.	DRILLING CONTRACTOR : Max's Enterprises Inc.	
DRILLING METHOD AND EQUIPMENT USED CME 750	LOGGER : E. Molander	
WATER LEVELS : 26' bgs	START : 11/19/04 1034	END : 1120

DEPTH BELOW SURFACE (FT)	STANDARD PENETRATION TEST RESULTS	SOIL DESCRIPTION	COMMENTS
INTERVAL (FT)	6"-6"-6" (N)	SOIL NAME, USCS GROUP SYMBOL, COLOR, MOISTURE CONTENT, RELATIVE DENSITY, OR CONSISTENCY, SOIL STRUCTURE, MINERALOGY.	DEPTH OF CASING, DRILLING RATE, DRILLING FLUID LOSS, TESTS, AND INSTRUMENTATION.
RECOVERY (FT)	#/TYPE		Notes
No Soil Sampling		0.0': Silty clay with trace sand and gravel (CL), dark brown, moist 2.0': Silty clay (CL), dark gray, moist, slight odor 3.0': Silt (ML), dark gray, moist, loose, very strong odor 5.0': Sandy silt (ML), gray, moist, loose, very strong odor, poorly graded 7.0': Grades darker gray with trace clay 9.0': Silt with trace clay (ML), dark gray, moist, strong odor 11.0': Sandy silt (ML), gray, moist, loose, poorly graded, very strong odor 13.0': Elastic silt (MH), gray, moist, very strong odor, slight sheen 15.0': Poorly graded sand (SP), gray, moist, loose, strong odor 17.0': Silty sand with clay (SM-SC), gray to dark gray, moist, loose, trace organic material (roots?), strong odor 19.0': Silty sand (SM), gray to dark gray, very moist, very strong odor 21.0': Silt (ML), dark gray, wet, sticky, soft, slight sheen 26.0': Free product in poorly graded sand (SP), gray, wet to saturated, metallic luster, iridescent, strong odor 35.0': End of boring	

R25E

NE

NW

34

35

SE

SW

MISSOURI RIVER


T10S

T11S

2

NW

N. KC
KC

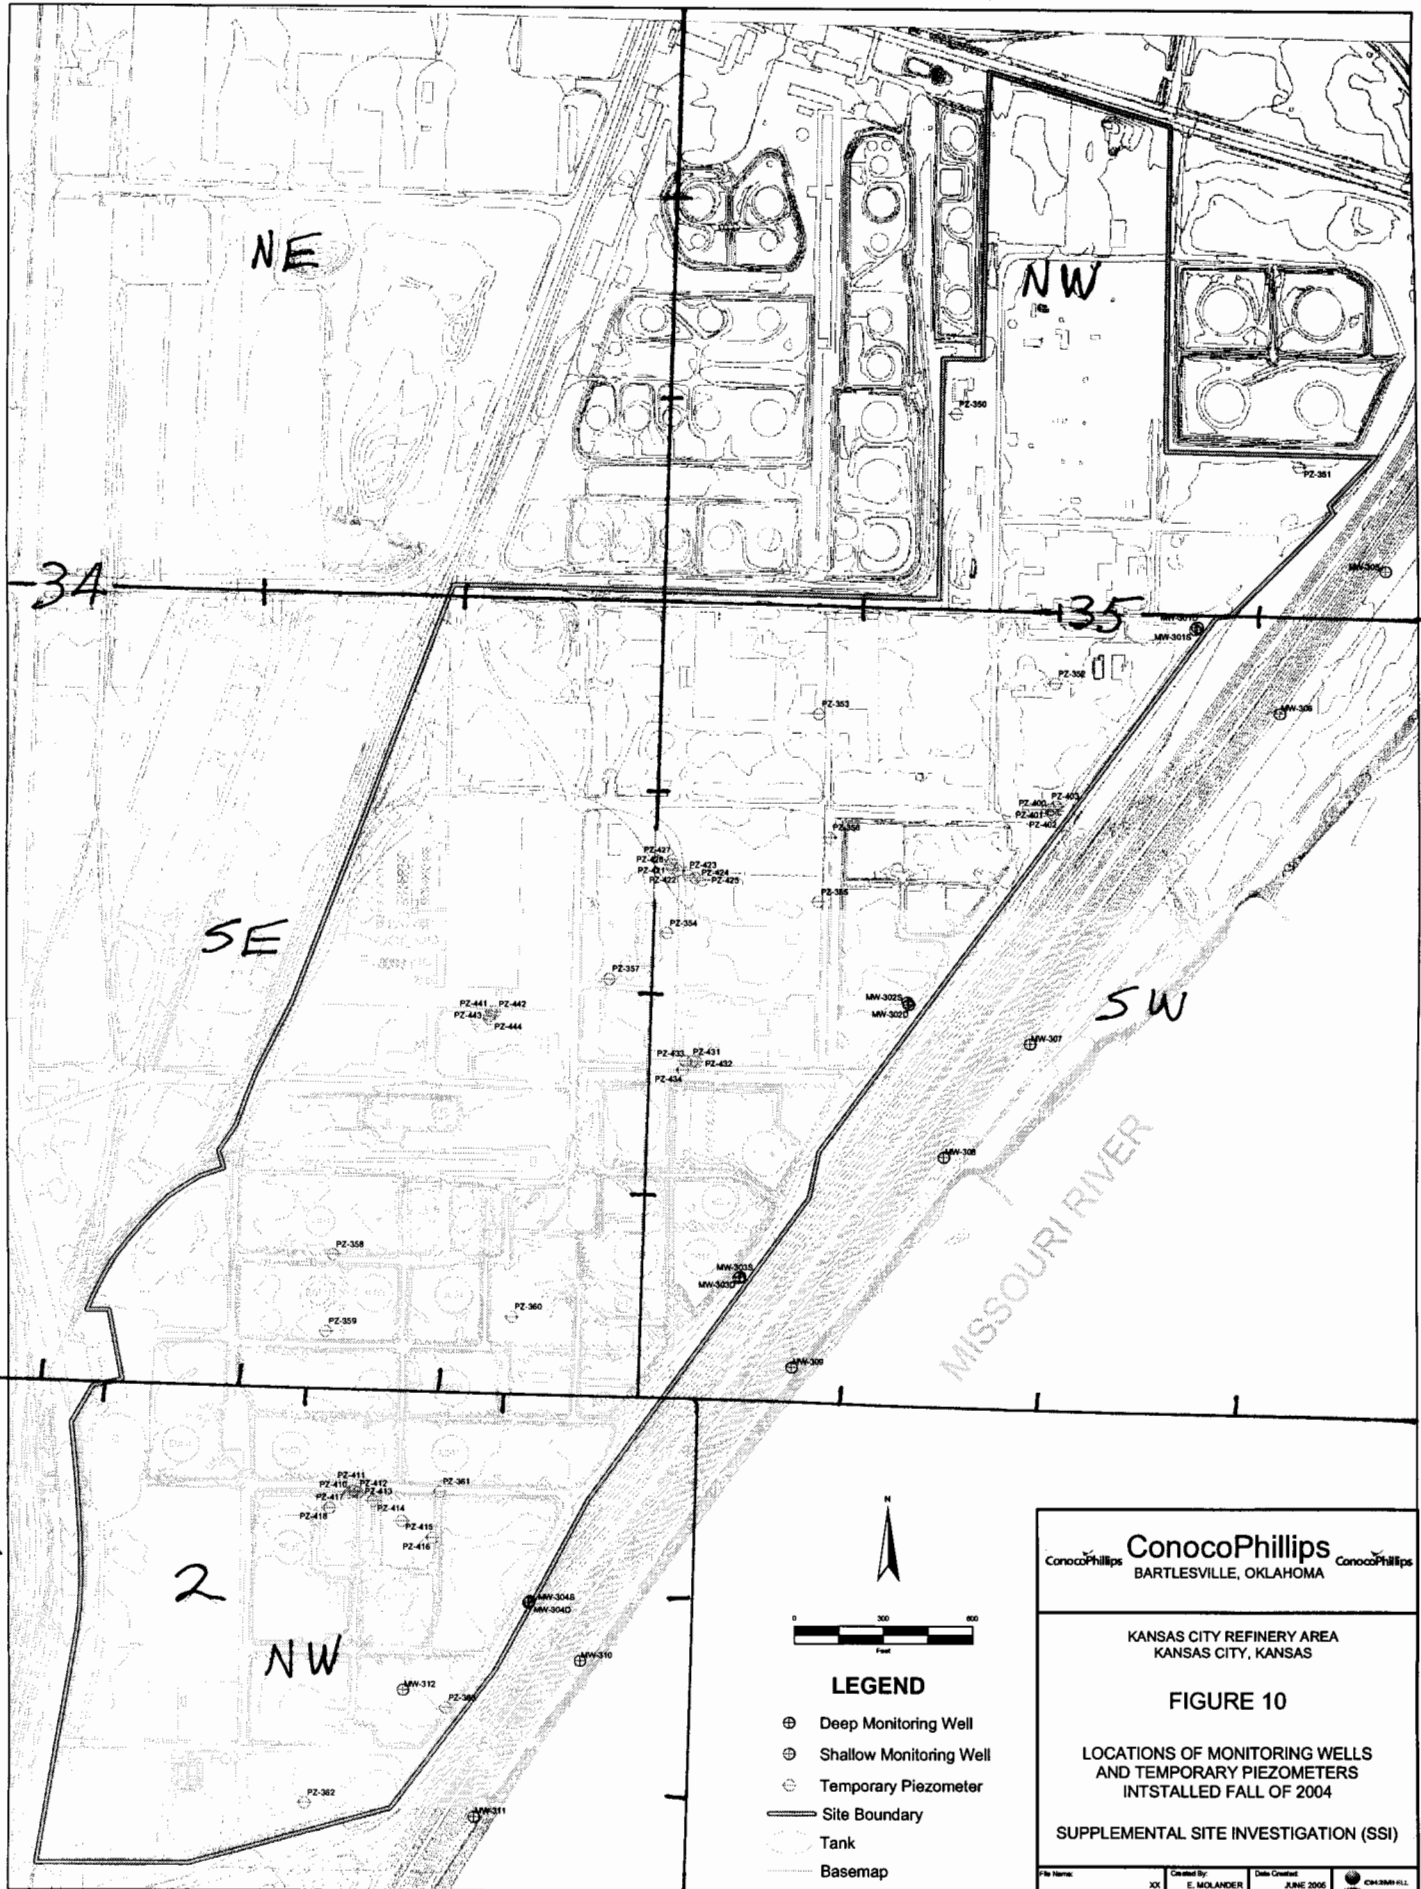

ConocoPhillips
BARTLESVILLE, OKLAHOMA

KANSAS CITY REFINERY AREA
KANSAS CITY, KANSAS

FIGURE 10

LOCATIONS OF MONITORING WELLS
AND TEMPORARY PIEZOMETERS
INSTALLED FALL OF 2004

SUPPLEMENTAL SITE INVESTIGATION (SSI)

File Name:	Created By:	Date Created:	C:\MSR\HILL
XX	E. MCLANDER	JUNE 2005	C:\MSR\HILL