

CORRECTION(S) TO WATER WELL RECORD (WWC-5)  
(to rectify lacking or incorrect information)

County: Wyandotte

Location listed as:

Location changed to:

Section-Township-Range: 34-10S-25E

34-10S-25E

Fraction (  $\frac{1}{4}$   $\frac{1}{4}$   $\frac{1}{4}$ ): E $\frac{1}{2}$  SE SW

S2 SW SE SE

Other changes: Initial statements: \_\_\_\_\_

Changed to: \_\_\_\_\_

Comments: \_\_\_\_\_

verification method: Map of well locations from owner, and  
North Kansas City 1:24,000 topo. map.

initials: DRL date: 9/9/2005

submitted by: Kansas Geological Survey, Data Resources Library, 1930 Constant Ave., Lawrence, KS 66047-3726  
to: Kansas Dept of Health & Environment, Bureau of Water, 1000 SW Jackson, Suite 420, Topeka, KS 66612-1367.

mv 65

1	LOCATION OF WATER WELL:	Fraction	Section	Number	Township	Number	Range	Number
	County: <u>Wyandotte</u>	<u>E 3/4 SE 1/4 SW 1/4</u>	<u>23</u>	<u>7</u>	<u>10</u>	<u>S</u>	<u>25</u>	<u>EW</u>

Distance and direction from nearest town or city street address of well if located within city?  
2029 Fairfax RCKS 06115

2 WATER WELL OWNER: Conoco Phillips Company, Keeler Ave  
 RR #, St. Address, Box #: 1218 Phillips Bldg 420 S  
 City, State, ZIP Code: Partlesville OR 71004  
 Board of Agriculture, Division of Water Resources  
 Application Number: \_\_\_\_\_

3 MARK WELL'S LOCATION WITH AN "X" IN SECTION BOX:

N		
NW		NE
SW		SE
S		

4 DEPTH OF WELL 23.72 ft.  
 WELL'S STATIC WATER LEVEL \_\_\_\_\_ ft.  
 WELL WAS USED AS:  
 1 Domestic                      5 Public Water Supply                      9 Dewatering  
 2 Irrigation                      6 Oil Field Water Supply                      10 Monitoring Well  
 3 Feedlot                      7 Domestic (Lawn & Garden)                      11 Injection Well  
 4 Industrial                      8 Air Conditioning                      12 Other \_\_\_\_\_

Was a chemical / bacteriological sample submitted to Department? Yes \_\_\_\_\_ No X  
 If yes, mo/day/yr sample was submitted \_\_\_\_\_  
 Water Well Disinfected: Yes \_\_\_\_\_ No X

5 TYPE OF BLANK CASING USED:

1 Steel	3 RMP (SR)	5 Wrought	7 Fiberglass	9 Other (Specify below)
<u>2</u> PVC	4 ABS	6 Asbestos-Cement	8 Concrete Tile	

Blank casing diameter 2 in.                      Was casing pulled? Yes X No \_\_\_\_\_                      If yes, how much All  
 Casing height above or below land surface 29 in.

6 GROUT PLUG MATERIAL: 1 Neat cement                      2 Cement grout                      3 Bentonite                      4 Other \_\_\_\_\_  
 Grout Plug Intervals: From 23.72 ft. to 0 ft., From \_\_\_\_\_ ft. to \_\_\_\_\_ ft., From \_\_\_\_\_ to \_\_\_\_\_ ft.

What is the nearest source of possible contamination:  
 1 Septic tank                      6 Seepage pit                      11 Fuel storage                      16 Other (specify below)  
 2 Sewer lines                      7 Pit privy                      12 Fertilizer storage  
 3 Watertight sewer lines                      8 Sewage lagoon                      13 Insecticide storage  
 4 Lateral lines                      9 Feedyard                      14 Abandoned water well  
 5 Cess pool                      10 Livestock pens                      15 Oil well/Gas well

Direction from well? \_\_\_\_\_                      How many feet? \_\_\_\_\_

FROM	TO	PLUGGING MATERIALS
<u>23.72</u>	<u>0</u>	<u>Cement Grout</u>

7 CONTRACTOR'S OR LANDOWNER'S CERTIFICATION: This water well was plugged under my jurisdiction and was completed on (mo/day/year) 11-30-04 and this record is true to the best of my knowledge and belief. Kansas Water Well Contractor's License No. 704 This Water Well Record was completed on (mo/day/year) 2-11-05 under the business name of MAXS by (signature) David Hingle

INSTRUCTIONS: Use typewriter or ball point pen, please press firmly and print clearly. Please fill in blanks, underline or circle the correct answers. Send top three copies to Kansas Department of Health and Environment, Bureau of Water, Geology Section, 1000 SW Jackson St., Ste. 420, Topeka, Kansas 66612-1367. Telephone: 785/296-5522. Send one to Water Well Owner and retain one for your records.

R25E

NE

34

35

SE

SW


T10S

T11S

2

NW

MISSOURI RIVER

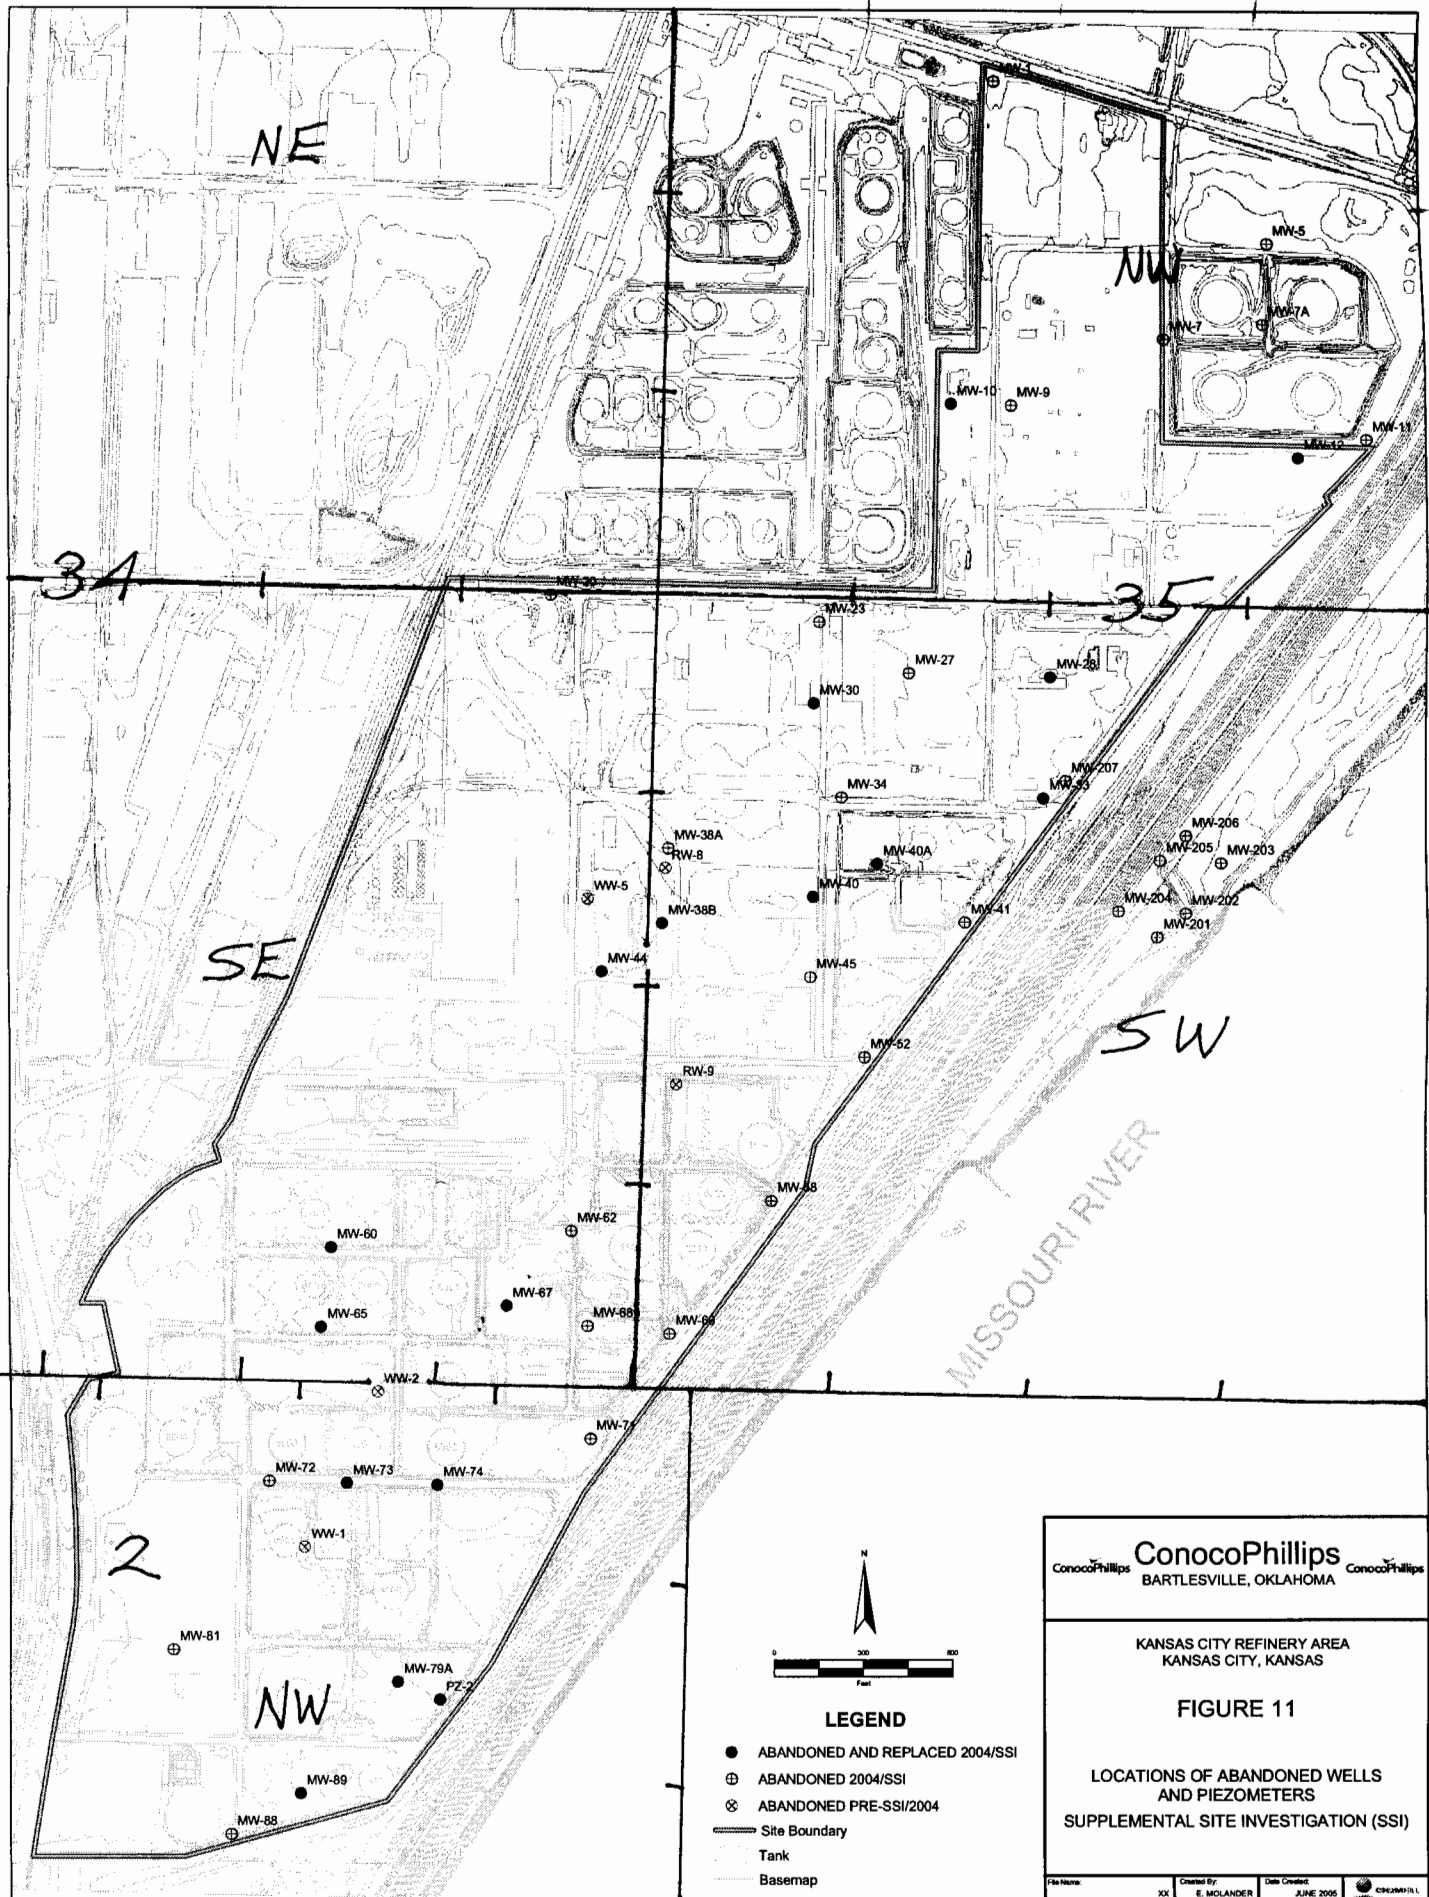

LEGEND

- ABANDONED AND REPLACED 2004/SSI
- ⊕ ABANDONED 2004/SSI
- ⊗ ABANDONED PRE-SSI/2004
- Site Boundary
- Tank
- Basemap

ConocoPhillips  
 BARTLESVILLE, OKLAHOMA

KANSAS CITY REFINERY AREA  
 KANSAS CITY, KANSAS

FIGURE 11

LOCATIONS OF ABANDONED WELLS  
 AND PIEZOMETERS  
 SUPPLEMENTAL SITE INVESTIGATION (SSI)