

CORRECTION(S) TO WATER WELL RECORD (WWC-5)

(to rectify lacking or incorrect information)

County: Wyandotte

Location listed as:

Section-Township-Range: 22-50N-33WFraction ($\frac{1}{4}$ $\frac{1}{4}$ $\frac{1}{4}$): NW NW NE

Location changed to:

35-10S-25ENE SE SE NW

Other changes: Initial statements: _____

Changed to: _____

Comments: _____

verification method: Map of well locations from owner, andNorth Kansas City 1:24,000 topo. map.initials: DRL date: 9/9/2005

submitted by: Kansas Geological Survey, Data Resources Library, 1930 Constant Ave., Lawrence, KS 66047-3726

to: Kansas Dept of Health & Environment, Bureau of Water, 1000 SW Jackson, Suite 420, Topeka, KS 66612-1367.


mw 11

1	LOCATION OF WATER WELL:	Fraction	Section	Number	Township	Number	Range	Number
	County: <i>Wyandotte</i>	<i>NW 1/4 Sec 12</i>	<i>22</i>		<i>50 N</i>		<i>33</i>	<i>E 1/4</i>

Distance and direction from nearest town or city street address of well if located within city?

2029 Fairfax Rcks 66115

2	WATER WELL OWNER: <i>Coroco Phillips Company</i>	RR #, St. Address, Box #: <i>1215 Phillips Bldg 426 S Reeler Ave</i>	Board of Agriculture, Division of Water Resources
	City, State, ZIP Code: <i>Barthesville OK 74004</i>	Application Number:	

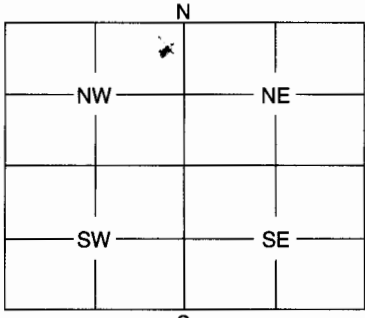3	MARK WELL'S LOCATION WITH AN "X" IN SECTION BOX:	4	DEPTH OF WELL <i>25.36</i> ft.
		WELL'S STATIC WATER LEVEL ft. WELL WAS USED AS: 1 Domestic 5 Public Water Supply 9 Dewatering 2 Irrigation 6 Oil Field Water Supply 10 Monitoring Well 3 Feedlot 7 Domestic (Lawn & Garden) 11 Injection Well 4 Industrial 8 Air Conditioning 12 Other	
Was a chemical / bacteriological sample submitted to Department? Yes No <i>X</i> If yes, mo/day/yr sample was submitted Water Well Disinfected: Yes No <i>X</i>			

5	TYPE OF BLANK CASING USED:			
	1 Steel	3 RMP (SR)	5 Wrought	7 Fiberglass
	2 PVC	4 ABS	6 Asbestos-Cement	8 Concrete Tile
	9 Other (Specify below)			
	Blank casing diameter <i>2</i> in. Was casing pulled? Yes <i>X</i> No If yes, how much <i>411</i>			
	Casing height above or below land surface <i>29"</i> in.			

6	GROUT PLUG MATERIAL:	1 Neat cement	<i>Cement grout</i>	3 Bentonite	4 Other
	Grout Plug Intervals:	From <i>25.36</i> ft.	to <i>0</i> ft.,	From ft.	to ft.,
	What is the nearest source of possible contamination:				
	1 Septic tank	6 Seepage pit	<i>11 Fuel storage</i>	16 Other (specify below)	
	2 Sewer lines	7 Pit privy	12 Fertilizer storage		
	3 Watertight sewer lines	8 Sewage lagoon	13 Insecticide storage		
	4 Lateral lines	9 Feedyard	14 Abandoned water well		
	5 Cess pool	10 Livestock pens	15 Oil well/Gas well		
	Direction from well? How many feet?				

FROM	TO	PLUGGING MATERIALS
<i>15.30</i>	<i>0</i>	<i>Cement Grout</i>

7	CONTRACTOR'S OF LANDOWNER'S CERTIFICATION: This water well was plugged under my jurisdiction and was completed on (mo/day/year) <i>12-7-04</i> and this record is true to the best of my knowledge and belief. Kansas Water Well Contractor's License No. <i>704</i> This Water Well Record was completed on (mo/day/year) <i>2-11-05</i> under the business name of by (signature) <i>David Ray</i>
---	--

INSTRUCTIONS: Use typewriter or ball point pen. Please press firmly and print clearly. Please fill in blanks, underline or circle the correct answers. Send top three copies to Kansas Department of Health and Environment, Bureau of Water, Geology Section, 1000 SW Jackson St., Ste. 420, Topeka, Kansas 66612-1367. Telephone: 785/296-5522. Send one to Water Well Owner and retain one for your records.

R25E

NE

NW

34

35

SE

SW


T10S

T11S

2

NW

MISSOURI RIVER

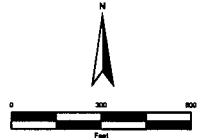

LEGEND

- ABANDONED AND REPLACED 2004/SSI
- ⊕ ABANDONED 2004/SSI
- ⊗ ABANDONED PRE-SSI/2004
- Site Boundary
- Tank
- Basemap

<p>ConocoPhillips BARTLESVILLE, OKLAHOMA</p>	
<p>KANSAS CITY REFINERY AREA KANSAS CITY, KANSAS</p>	
<p>FIGURE 11</p>	
<p>LOCATIONS OF ABANDONED WELLS AND PIEZOMETERS SUPPLEMENTAL SITE INVESTIGATION (SSI)</p>	
<p>File Name:</p>	<p>Created By: E. MOLANDER</p>
<p>Date Created: JUNE 2005</p>	<p>CS2005-10.1</p>