

CORRECTION(S) TO WATER WELL RECORD (WWC-5)
(to rectify lacking or incorrect information)

Location listed as:

Section-Township-Range: 22-50N-33W

Fraction (¼ ¼ ¼): NW NW NE

County: Wyandotte

Location changed to:

35-10S-25E

NW SE SE NW

Other changes: Initial statements: _____

Changed to: _____


Comments: _____

verification method: Map of well locations from owner, and
North Kansas City 1:24,000 topo. map.

initials: DRJ date: 9/9/2005

submitted by: Kansas Geological Survey, Data Resources Library, 1930 Constant Ave., Lawrence, KS 66047-3726
to: Kansas Dept of Health & Environment, Bureau of Water, 1000 SW Jackson, Suite 420, Topeka, KS 66612-1367.

R 25 E

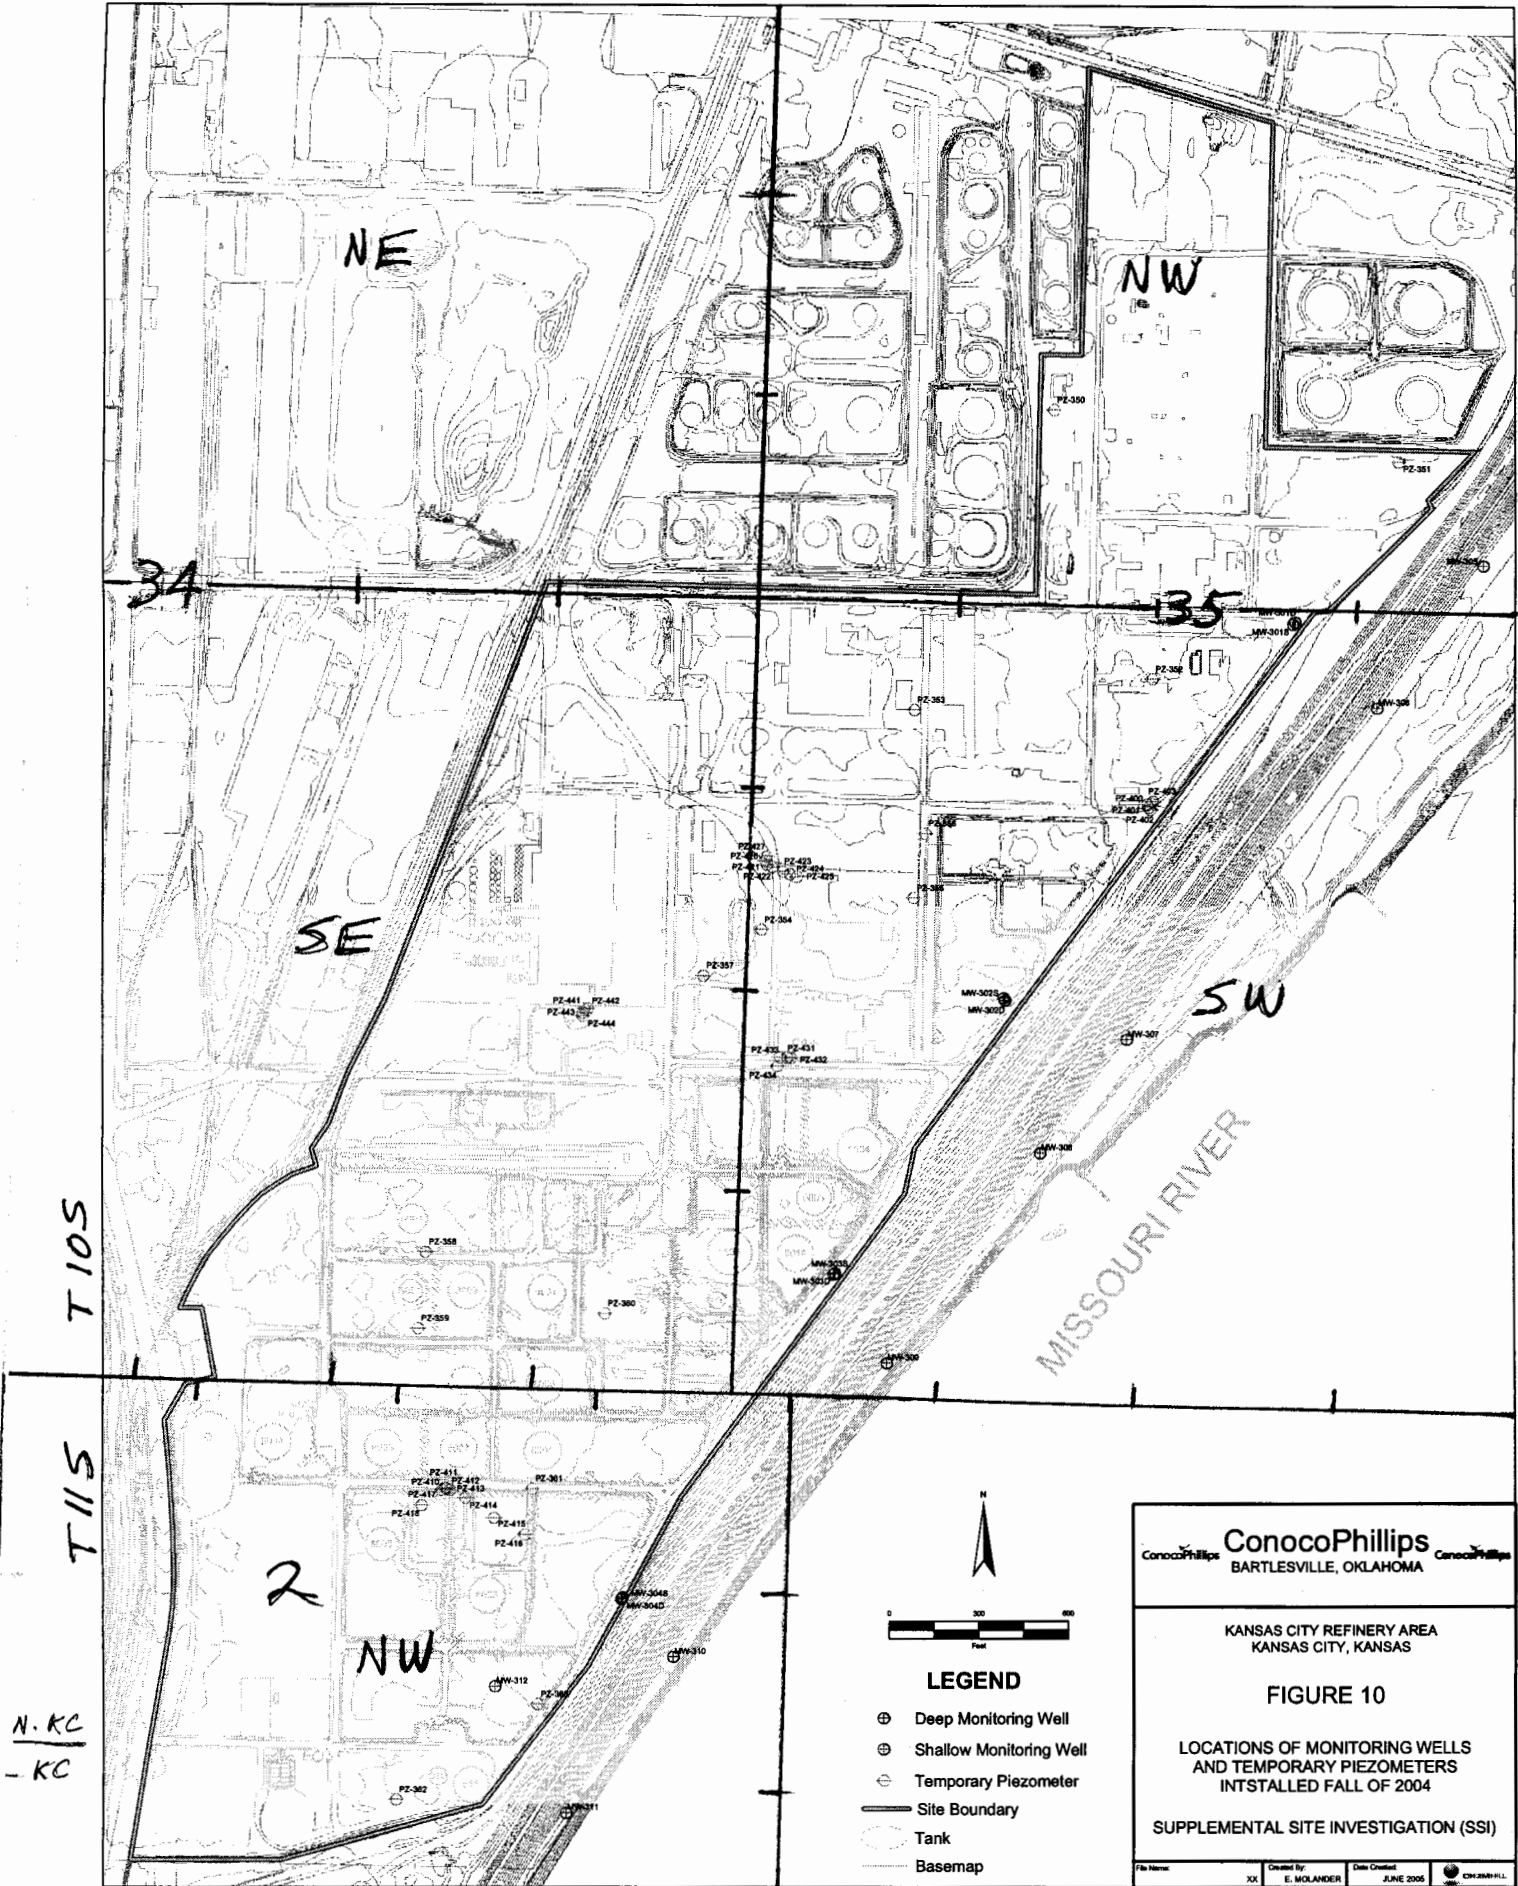

N.KC
- KC

ConocoPhillips
 BARTLESVILLE, OKLAHOMA

KANSAS CITY REFINERY AREA
 KANSAS CITY, KANSAS

FIGURE 10
 LOCATIONS OF MONITORING WELLS
 AND TEMPORARY PIEZOMETERS
 INSTALLED FALL OF 2004

SUPPLEMENTAL SITE INVESTIGATION (SSI)

File Name: XX | Created By: E. MOLANDER | Date Created: JUNE 2005 | CW 2004-11

R 26 E