

CORRECTION(S) TO WATER WELL RECORD (WWC-5)

(to rectify lacking or incorrect information)

County: Wyandotte

Location listed as:

Section-Township-Range: 22-50N-33W

Fraction (  $\frac{1}{4}$   $\frac{1}{4}$   $\frac{1}{4}$ ): NW NE NE

Location changed to:

35-10S-25E

SE SE SE NW

Other changes: Initial statements: \_\_\_\_\_

Changed to: \_\_\_\_\_

Comments: \_\_\_\_\_

verification method: Map of well locations from owner, and  
North Kansas City 1:24,000 topo. map.

initials: ARL date: 9/9/2005

submitted by: Kansas Geological Survey, Data Resources Library, 1930 Constant Ave., Lawrence, KS 66047-3726  
to: Kansas Dept of Health & Environment, Bureau of Water, 1000 SW Jackson, Suite 420, Topeka, KS 66612-1367.






PROJECT NUMBER 321564.SI.01	BORING NUMBER MW-305	SHEET 1 OF 1
--------------------------------	-------------------------	--------------

## SOIL BORING LOG

PROJECT : Conoco Phillips - Supplemental SI	NORTHING: 310510.56	EASTING: 2277919.47
ELEVATION : 744.34 ft b.t.o.c.	DRILLING CONTRACTOR : Max's Enterprises Inc.	
DRILLING METHOD AND EQUIPMENT USED CME 750	LOGGER : E. Molander	
WATER LEVELS : 32.0' bgs during drilling	START : 11/17/04 1012	END : 11/17/04 1040


DEPTH BELOW SURFACE (FT)		STANDARD PENETRATION TEST RESULTS	SOIL DESCRIPTION	COMMENTS
INTERVAL (FT)	RECOVERY (FT)	6"-6"-6" (N)	SOIL NAME, USCS GROUP SYMBOL, COLOR, MOISTURE CONTENT, RELATIVE DENSITY, OR CONSISTENCY, SOIL STRUCTURE, MINERALOGY.	DEPTH OF CASING, DRILLING RATE, DRILLING FLUID LOSS, TESTS, AND INSTRUMENTATION.
	#/TYPE			Notes
0.0' - 3.5'			0.0': Silty clay (CL), dark brown to dark gray, firm/stiff, highly plastic, no odor, organic debris 0.5': Silt with sand, clay and gravel (ML), brown, moist, well graded, no odor 3.5': Gravel/ limestone refusal from levee construction	
3.5' - 4.5'			4.5': Silt (ML), brown, very moist, natural organic odor	
4.5' - 6.0'			black staining, moist, strong HC odor, trace black 6.0': Silty sand (SM), brown, wet	
6.0' - 7.0'			7.0': Well sorted sand (SW), brown, moist, fine to medium	
7.0' - 17.0'				
17.0' - 21.0'			17.0': Poorly graded sand with trace gravel and sand (SP), gray, moist, fine gravel, coarse sand	
21.0' - 30.0'			21.0': Dark gray	
30.0' - 34.10'			30.0': Sand becoming slightly finer, fine to medium  34.10': End of boring	

R 25 E

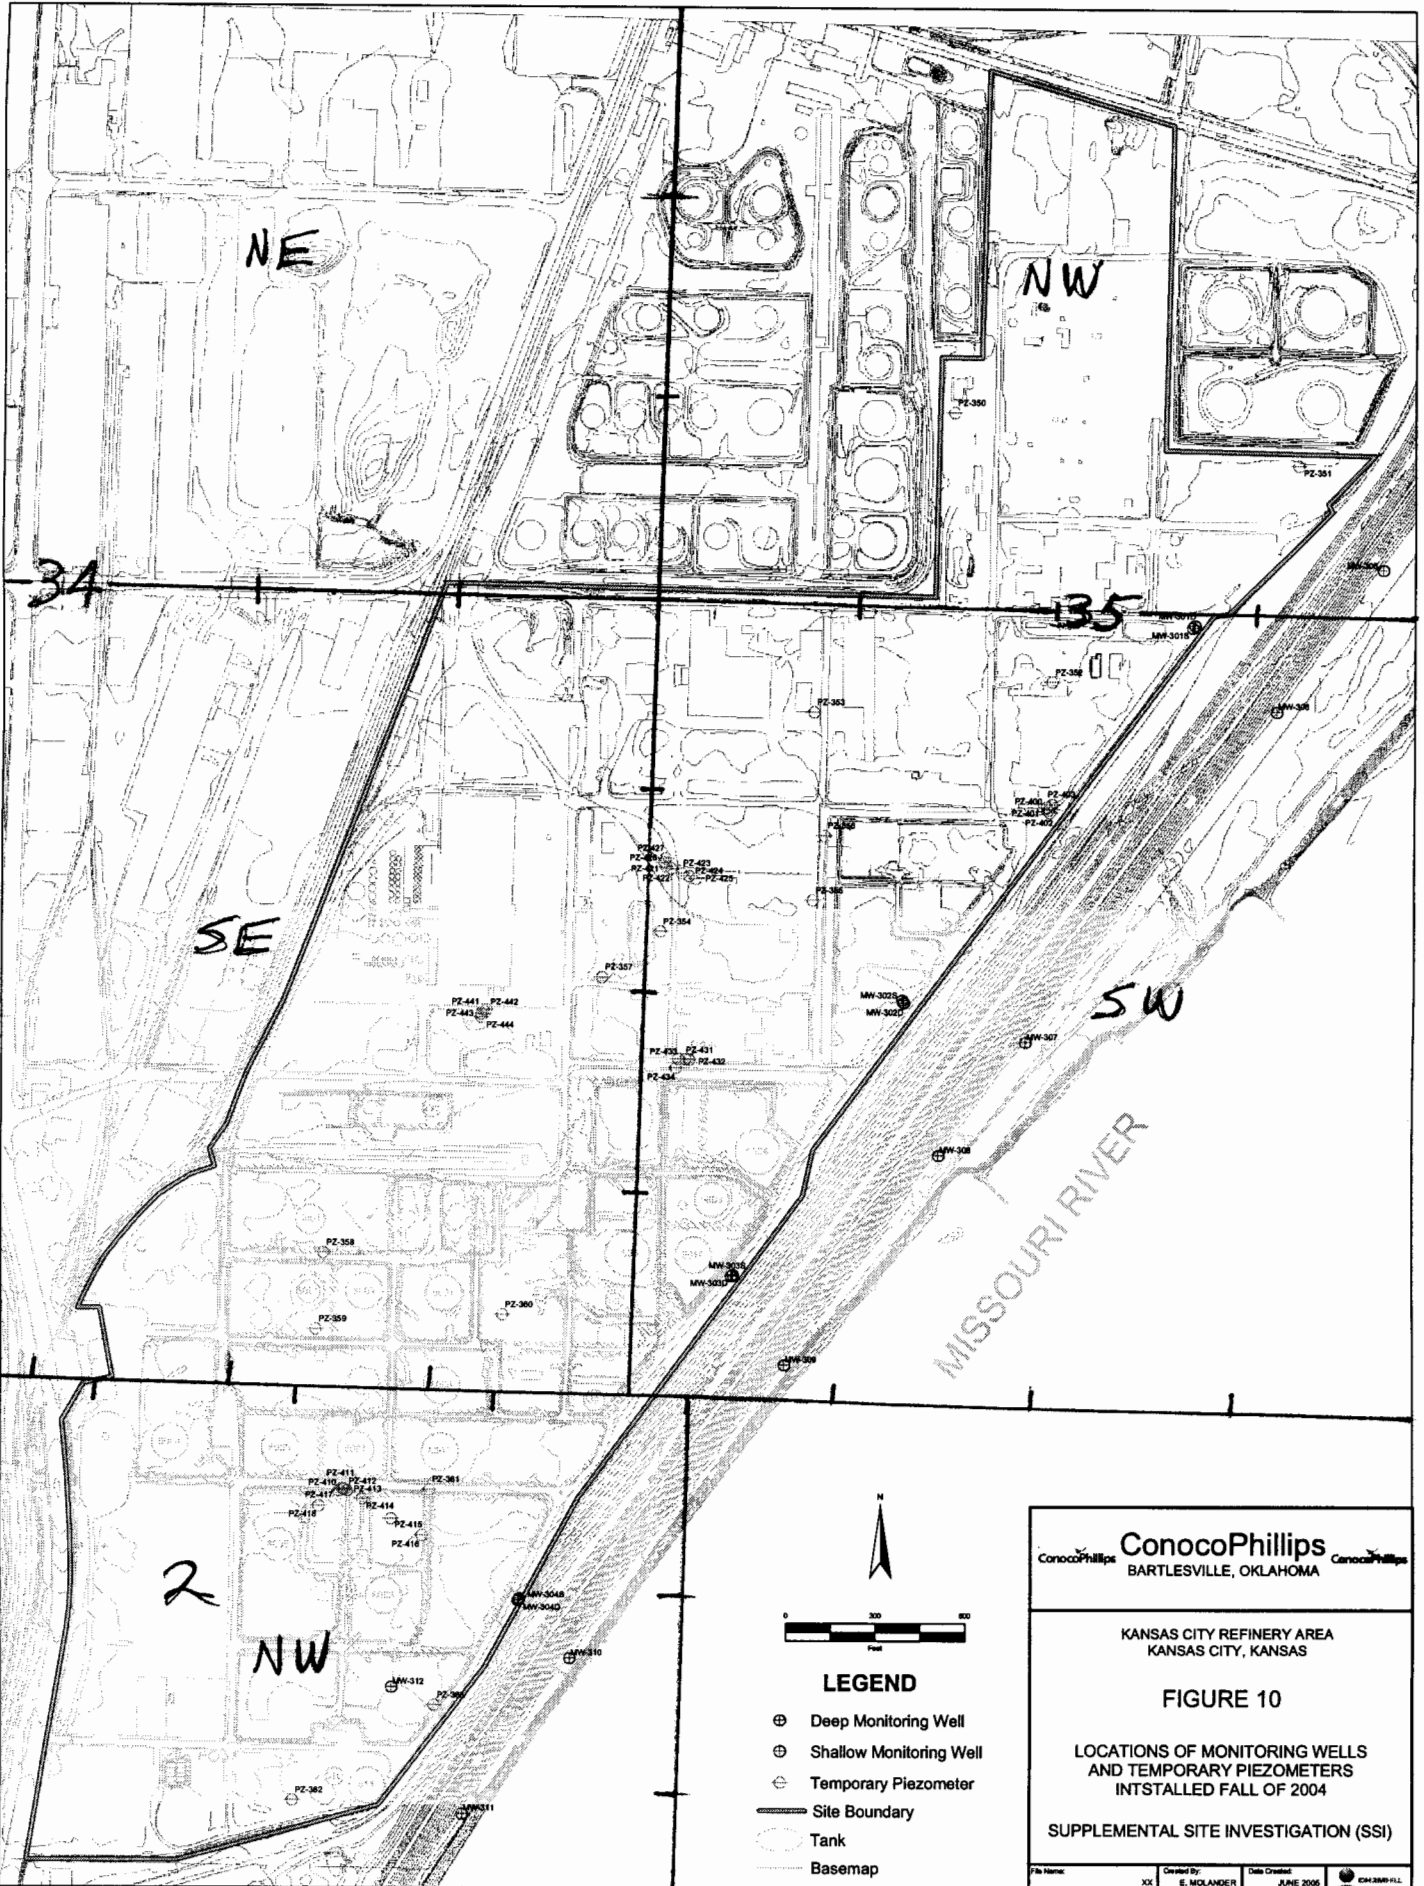

T10S  
T11S  
N. KC  
- KC

R 25 E


**ConocoPhillips**  
 BARTLESVILLE, OKLAHOMA

---


KANSAS CITY REFINERY AREA  
 KANSAS CITY, KANSAS

**FIGURE 10**  
 LOCATIONS OF MONITORING WELLS  
 AND TEMPORARY PIEZOMETERS  
 INSTALLED FALL OF 2004

SUPPLEMENTAL SITE INVESTIGATION (SSI)

---

File Name: XX Created By: E. MCLANDER Date Created: JUNE 2005

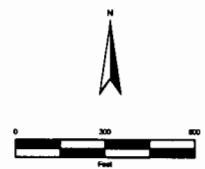

**LEGEND**

- ⊕ Deep Monitoring Well
- ⊕ Shallow Monitoring Well
- ⊕ Temporary Piezometer
- Site Boundary
- Tank
- Basemap