

CORRECTION(S) TO WATER WELL RECORD (WWC-5)

(to rectify lacking or incorrect information)

County: Wyandotte

Location listed as:

Section-Township-Range: 22-50N-33W

Fraction (  $\frac{1}{4}$   $\frac{1}{4}$   $\frac{1}{4}$ ): NW NW NW

Location changed to:

35-10S-25E

E2 SW NW

Other changes: Initial statements: \_\_\_\_\_

Changed to: \_\_\_\_\_

Comments: \_\_\_\_\_

verification method: Map of well locations from owner, and  
North Kansas City 1:24,000 topo. map.

initials: DRB date: 9/9/2005

submitted by: Kansas Geological Survey, Data Resources Library, 1930 Constant Ave., Lawrence, KS 66047-3726  
to: Kansas Dept of Health & Environment, Bureau of Water, 1000 SW Jackson, Suite 420, Topeka, KS 66612-1367.

MW 10

1	LOCATION OF WATER WELL:	Fraction	Section Number	Township Number	Range Number
County:	Wyandotte	1/4 Sec 22 1/4	22	S0N	33 EW

Distance and direction from nearest town or city street address of well if located within city?  
2029 Fairfax RCKS 66115

2 WATER WELL OWNER: Conoco Phillips Company  
 RR #, St. Address, Box #: 1218 Phillips Bldg. 420 S Keeler Ave  
 City, State, ZIP Code: Bartlesville OK 74004  
 Board of Agriculture, Division of Water Resources  
 Application Number:

3 MARK WELL'S LOCATION WITH AN "X" IN SECTION BOX:

N		
NW		NE
W		E
SW		SE
S		

4 DEPTH OF WELL 23.96 ft.  
 WELL'S STATIC WATER LEVEL ..... ft.  
 WELL WAS USED AS:

1 Domestic	5 Public Water Supply	9 Dewatering
2 Irrigation	6 Oil Field Water Supply	10 Monitoring Well
3 Feedlot	7 Domestic (Lawn & Garden)	11 Injection Well
4 Industrial	8 Air Conditioning	12 Other .....

Was a chemical / bacteriological sample submitted to Department? Yes ..... No ~~.....~~  
 If yes, mo/day/yr sample was submitted .....

Water Well Disinfected: Yes ..... No ~~.....~~

5 TYPE OF BLANK CASING USED:

1 Steel	3 RMP (SR)	5 Wrought	7 Fiberglass	9 Other (Specify below)
2 PVC	4 ABS	6 Asbestos-Cement	8 Concrete Tile	

Blank casing diameter 2 in. Was casing pulled? Yes ~~.....~~ No ..... If yes, how much 411  
 Casing height above or below land surface 29 in.

6 GROUT PLUG MATERIAL: 1 Neat cement 2 Cement grout 3 Bentonite 4 Other .....

Grout Plug Intervals: From 23.96 ft. to 0 ft., From ..... ft. to ..... ft., From ..... to ..... ft.

What is the nearest source of possible contamination:

1 Septic tank	6 Seepage pit	11 Fuel storage	16 Other (specify below)
2 Sewer lines	7 Pit privy	12 Fertilizer storage	
3 Watertight sewer lines	8 Sewage lagoon	13 Insecticide storage	
4 Lateral lines	9 Feedyard	14 Abandoned water well	
5 Cess pool	10 Livestock pens	15 Oil well/Gas well	

Direction from well? ..... How many feet? .....

FROM	TO	PLUGGING MATERIALS
23.96	0	Cement Grout

7 CONTRACTOR'S OF LANDOWNER'S CERTIFICATION: This water well was plugged under my jurisdiction and was completed on (mo/day/year) 11-10-04 and this record is true to the best of my knowledge and belief. Kansas Water Well Contractor's License No. 704 This Water Well Record was completed on (mo/day/year) 1-11-05 under the business name of MAXS by (signature) David Hunter

INSTRUCTIONS: Use typewriter or ball point pen. Please press firmly and print clearly. Please fill in blanks, underline or circle the correct answers. Send top three copies to Kansas Department of Health and Environment, Bureau of Water, Geology Section, 1000 SW Jackson St., Ste. 420, Topeka, Kansas 66612-1367. Telephone: 785/296-5522. Send one to Water Well Owner and retain one for your records.

R 25 E

NE

NW

34

35

SE

SW



T10S

T11S

2

NW

MISSOURI RIVER

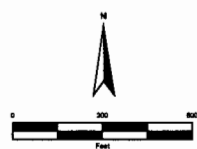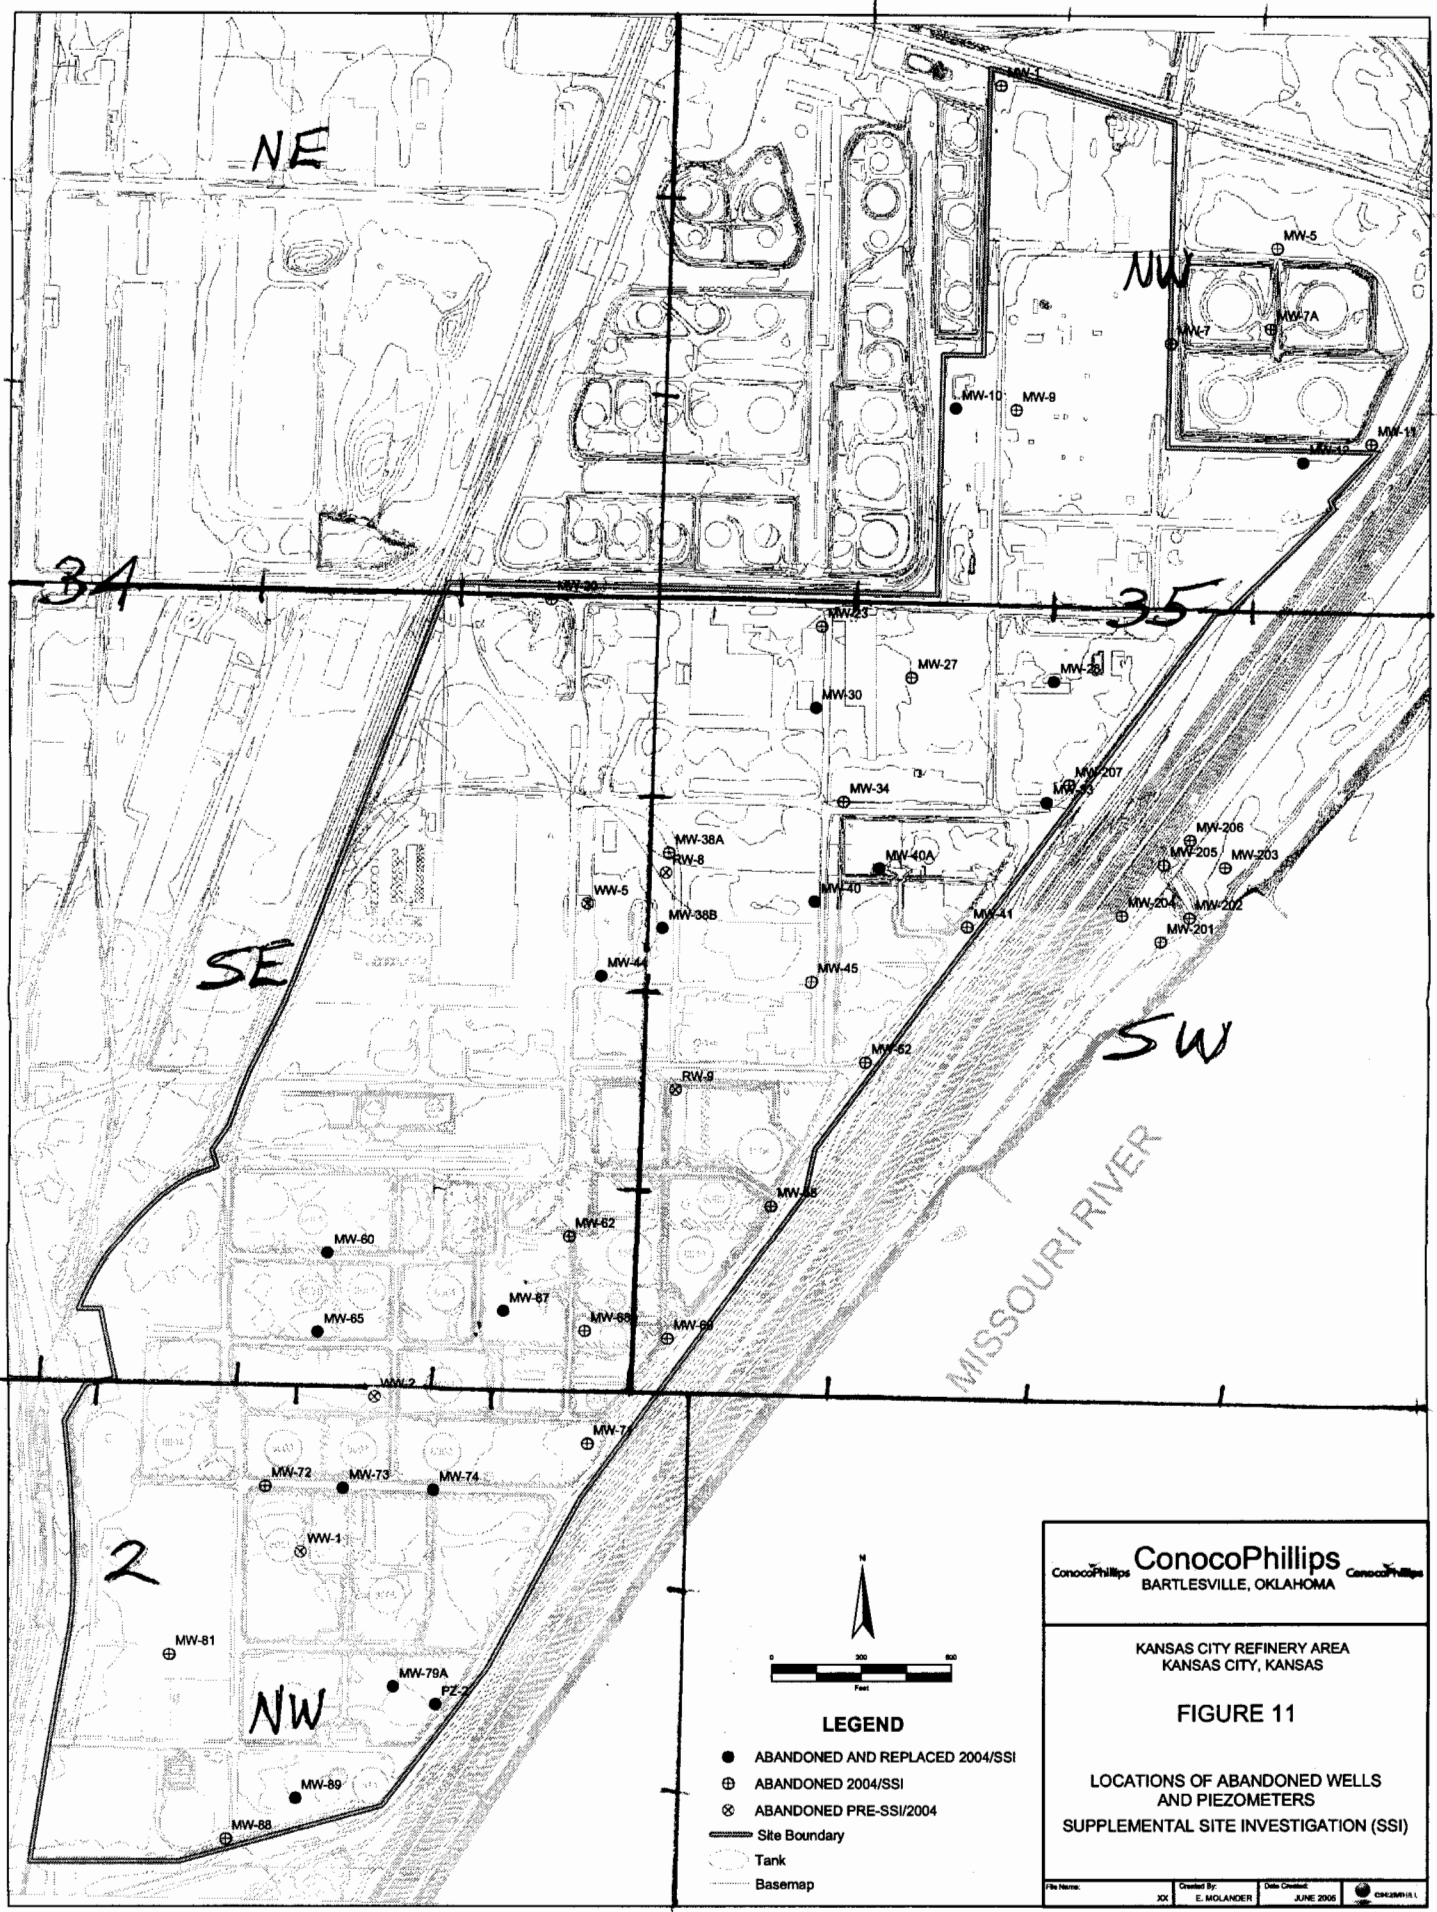

**LEGEND**

- ABANDONED AND REPLACED 2004/SSI
- ⊕ ABANDONED 2004/SSI
- ⊗ ABANDONED PRE-SSI/2004
- Site Boundary
- Tank
- Basemap

<p><b>ConocoPhillips</b> BARTLESVILLE, OKLAHOMA</p>	
<p>KANSAS CITY REFINERY AREA KANSAS CITY, KANSAS</p>	
<p><b>FIGURE 11</b></p>	
<p>LOCATIONS OF ABANDONED WELLS AND PIEZOMETERS SUPPLEMENTAL SITE INVESTIGATION (SSI)</p>	
File Name:	<p>Created By: E. MOLLANDER Date Created: JUNE 2005</p>